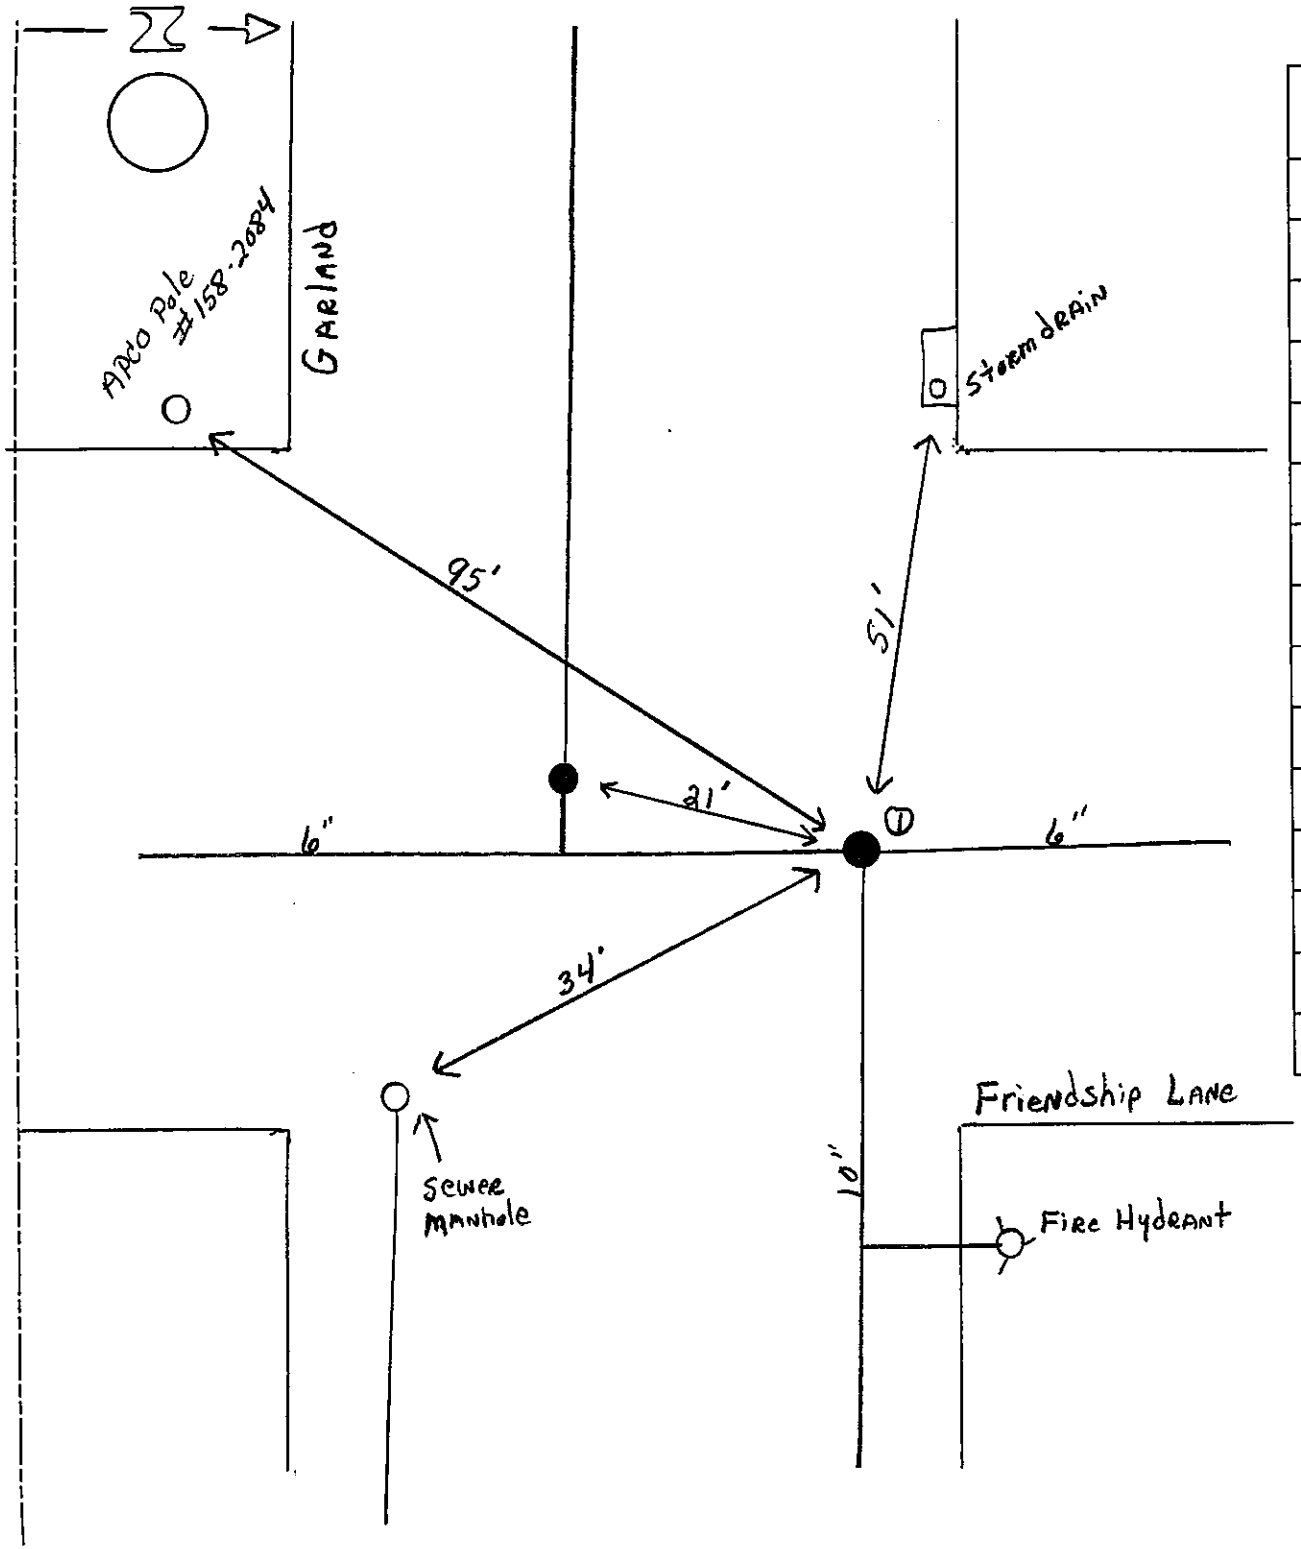

DATE	NO.	SIZE	MAKE	OPEN	TURNS
11/05	1	6"	American Darling	L	21

WESTERN VIRGINIA WATER AUTHORITY

VALVE DIAGRAM

Intersection of Friendship Lane and Garland Dr.

N.E. County

SECT. MAP

DATE 11/05