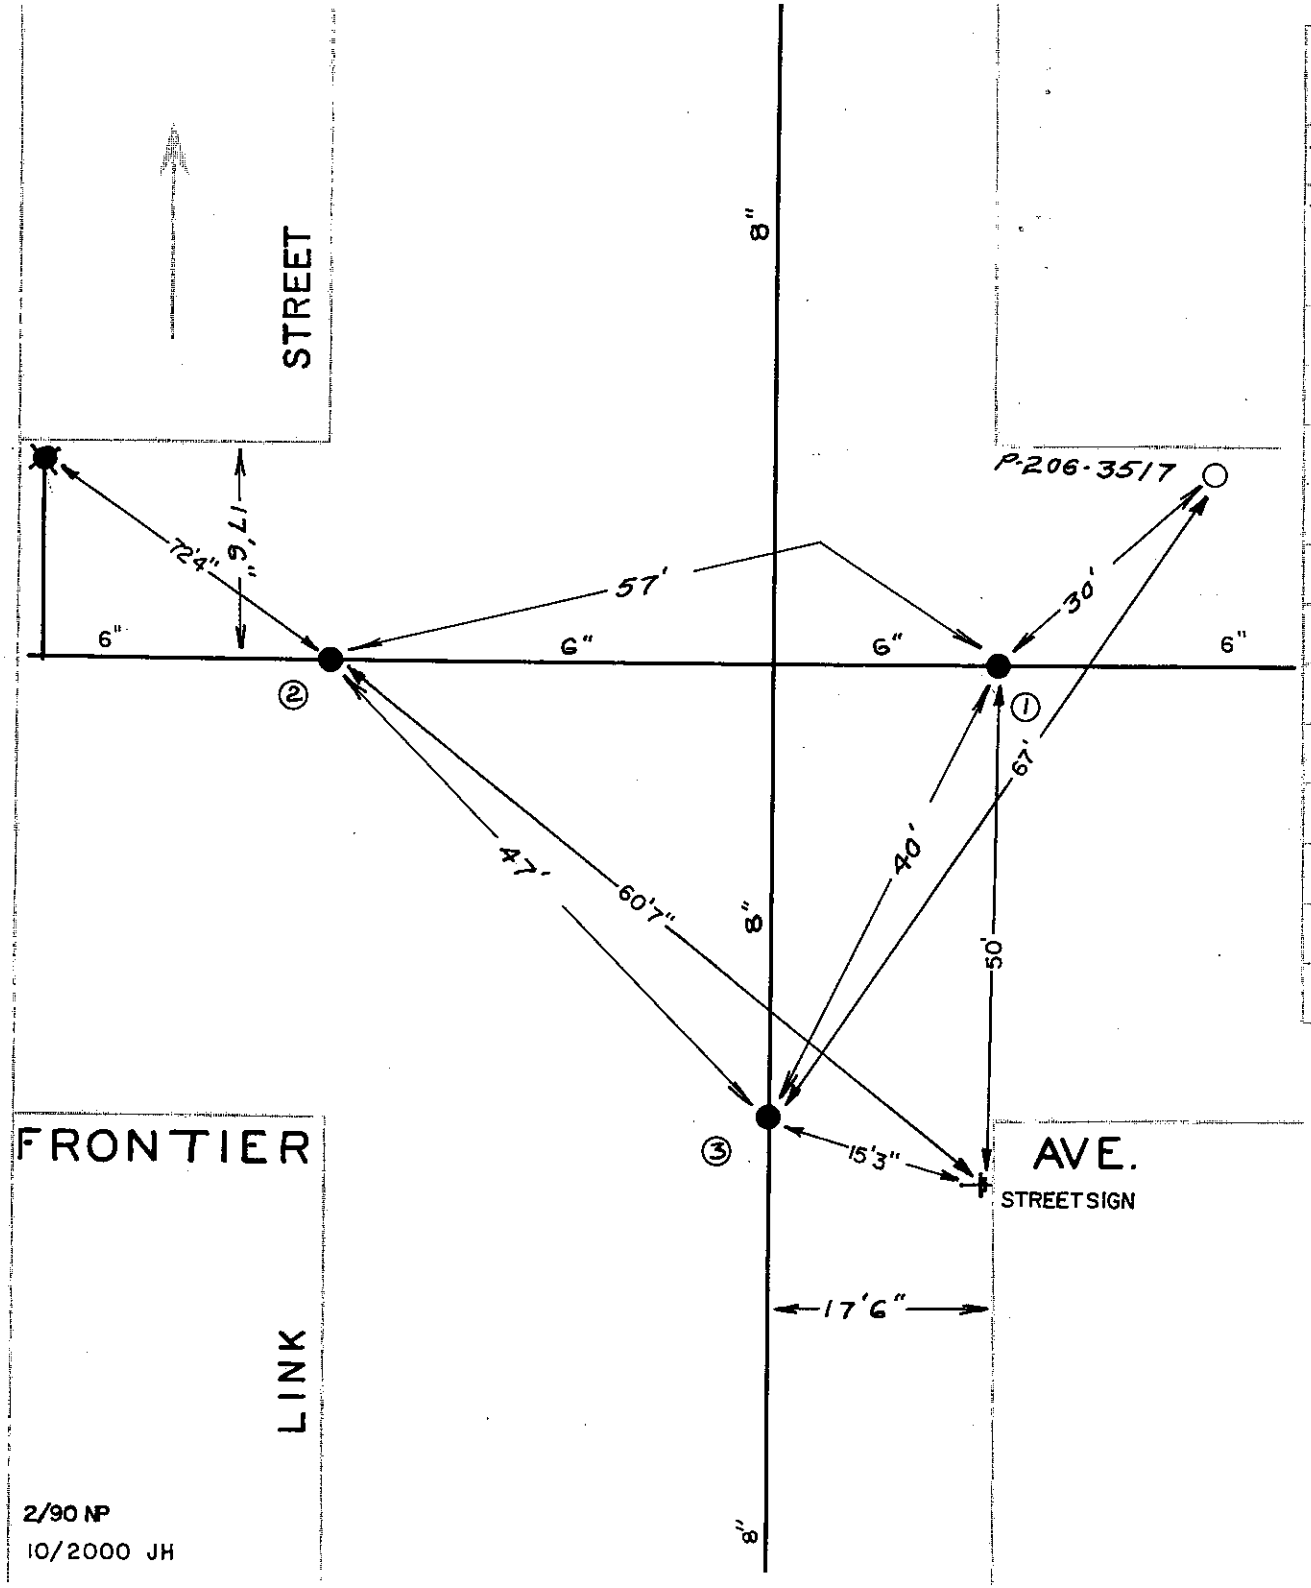

DATE	NO	SIZE	MAKE	OPEN	TURNS
7-56	1	6"	MUELLER	R	
7-56	2	6"	MUELLER	R	
7-56	3	8"	MUELLER	R	
	1	0	EPL		
	2	0	WPL		
	3	0	SPL		

CITY OF ROANOKE—WATER DEPT

VALVE DIAGRAM

FRONTIER AVE. &

LINK ST.

SEC MAP 319, 320 N.E.

DATE PAGE NO

2/90 NP

10/2000 JH