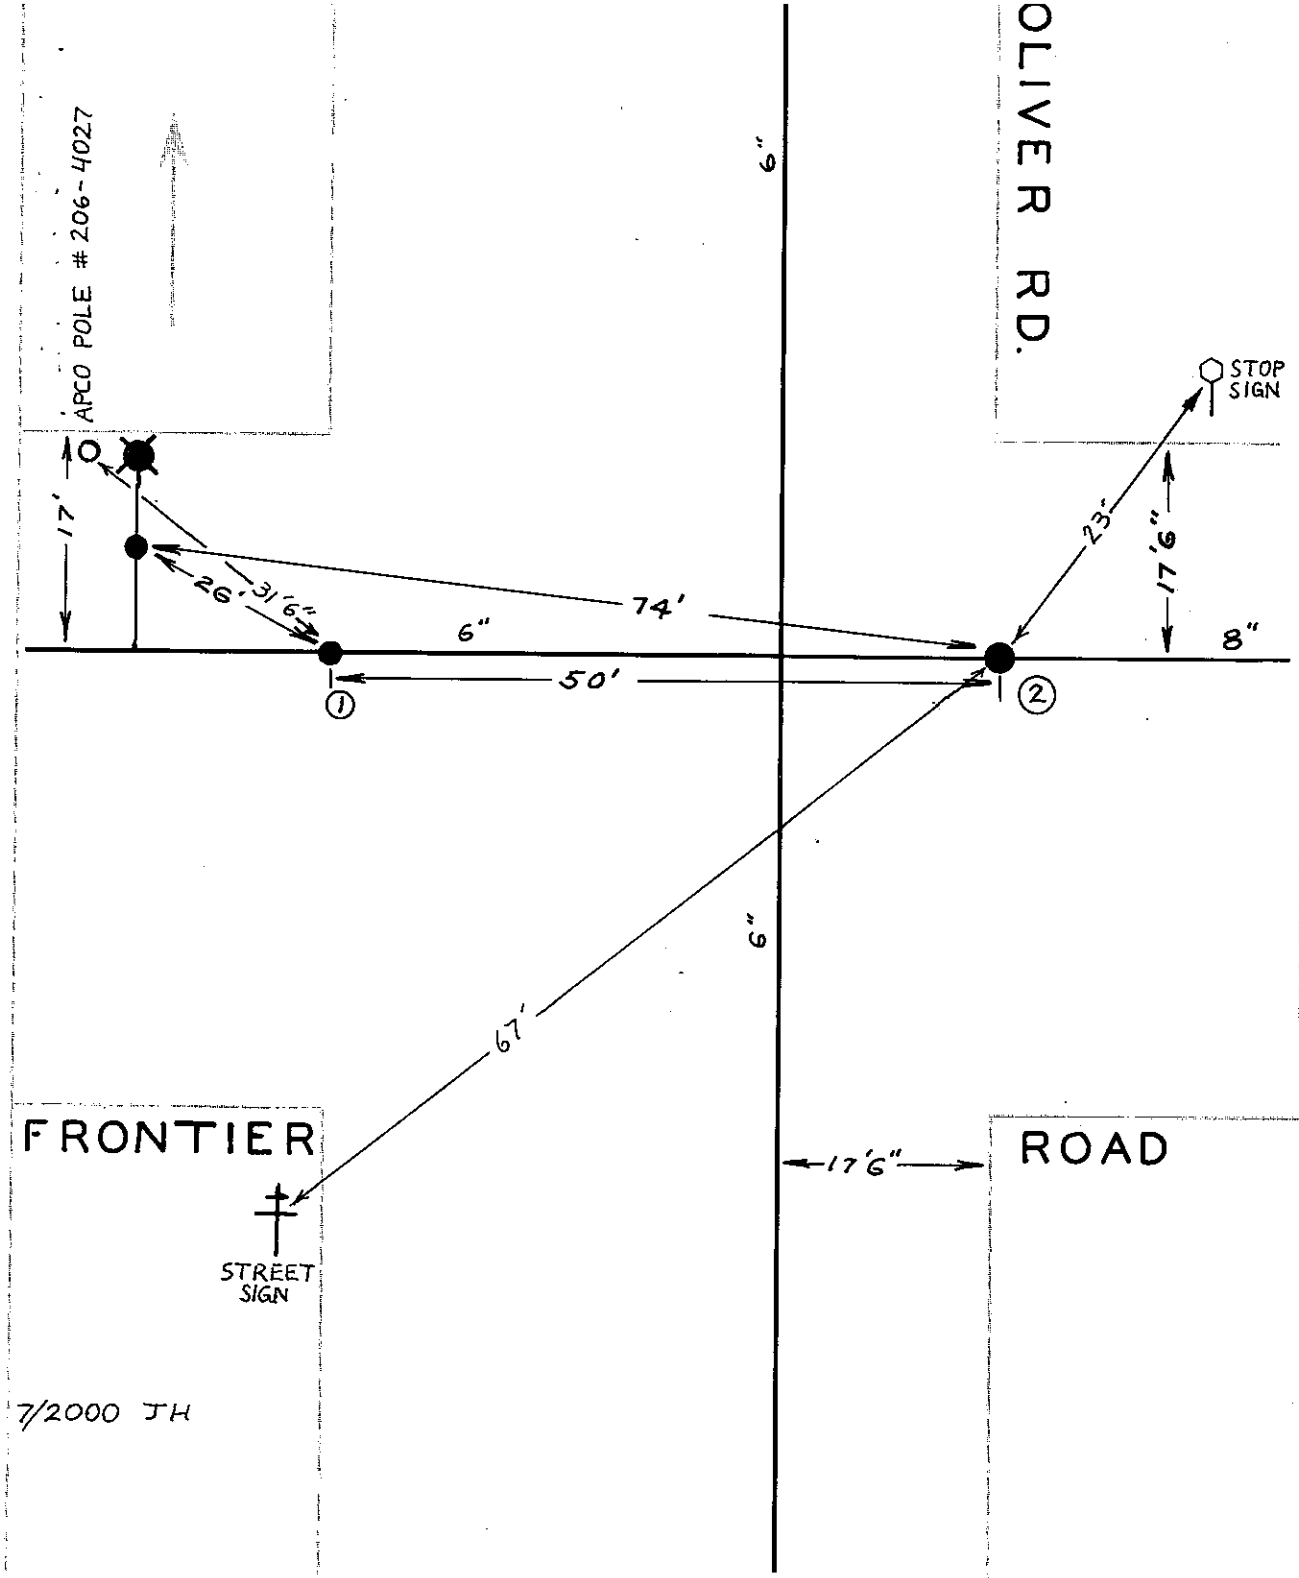

DATE	NO	SIZE	MAKE	OPEN	INKES
7-56	1	6"	MUELLER	R	
4-57	2	8"	DARLING	R	
	1	0	WPL		
	2	0	EPL		

CITY OF ROANOKE - WATER DEPT
VALVE DIAGRAM

FRONTIER RD. &
OLIVER RD. N.E.

SEC. MAP 319