DATE	NO	SIZE	NAME	CLASS	(Mm)
1959	1	8"	DARLING	R	
1968	2	12"	MUELLER	R	
	1	0	SPL		

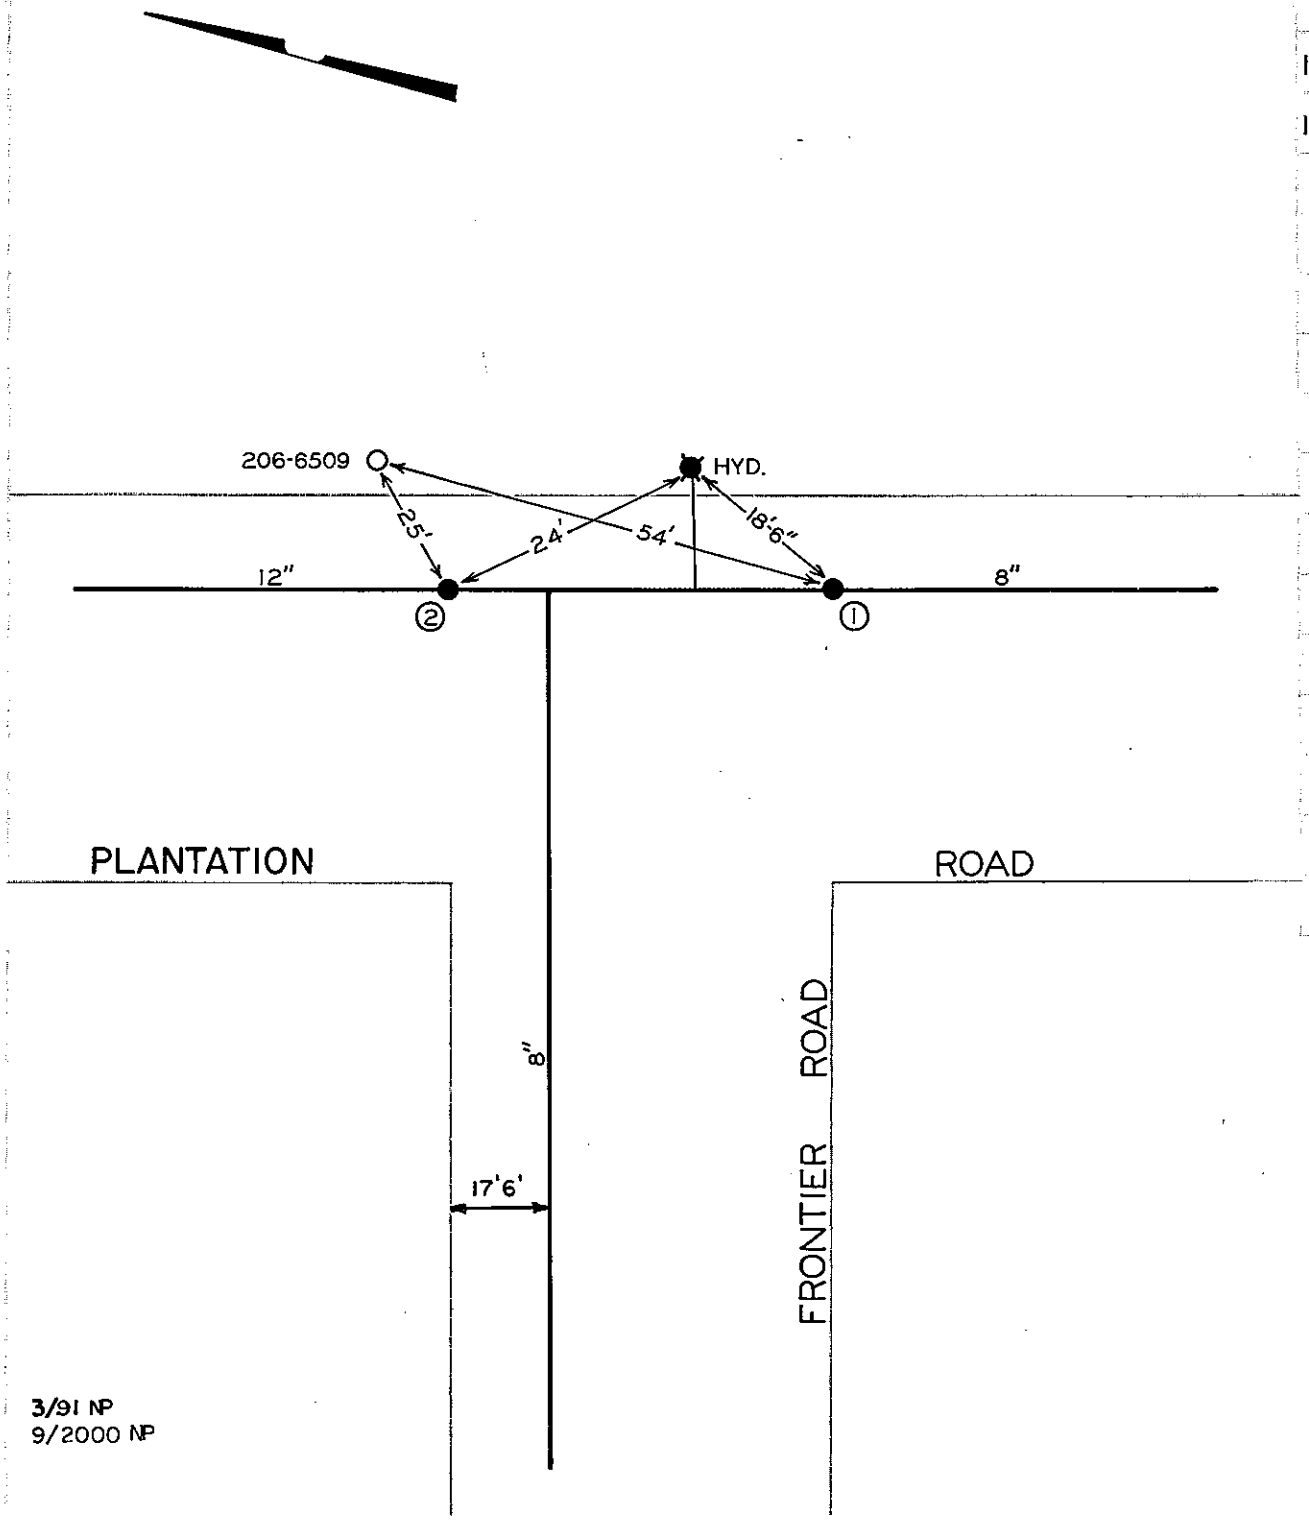

3/91 NP
9/2000 NP

FRONTIER ROAD &
PLANTATION ROAD

330, 319 N.E.