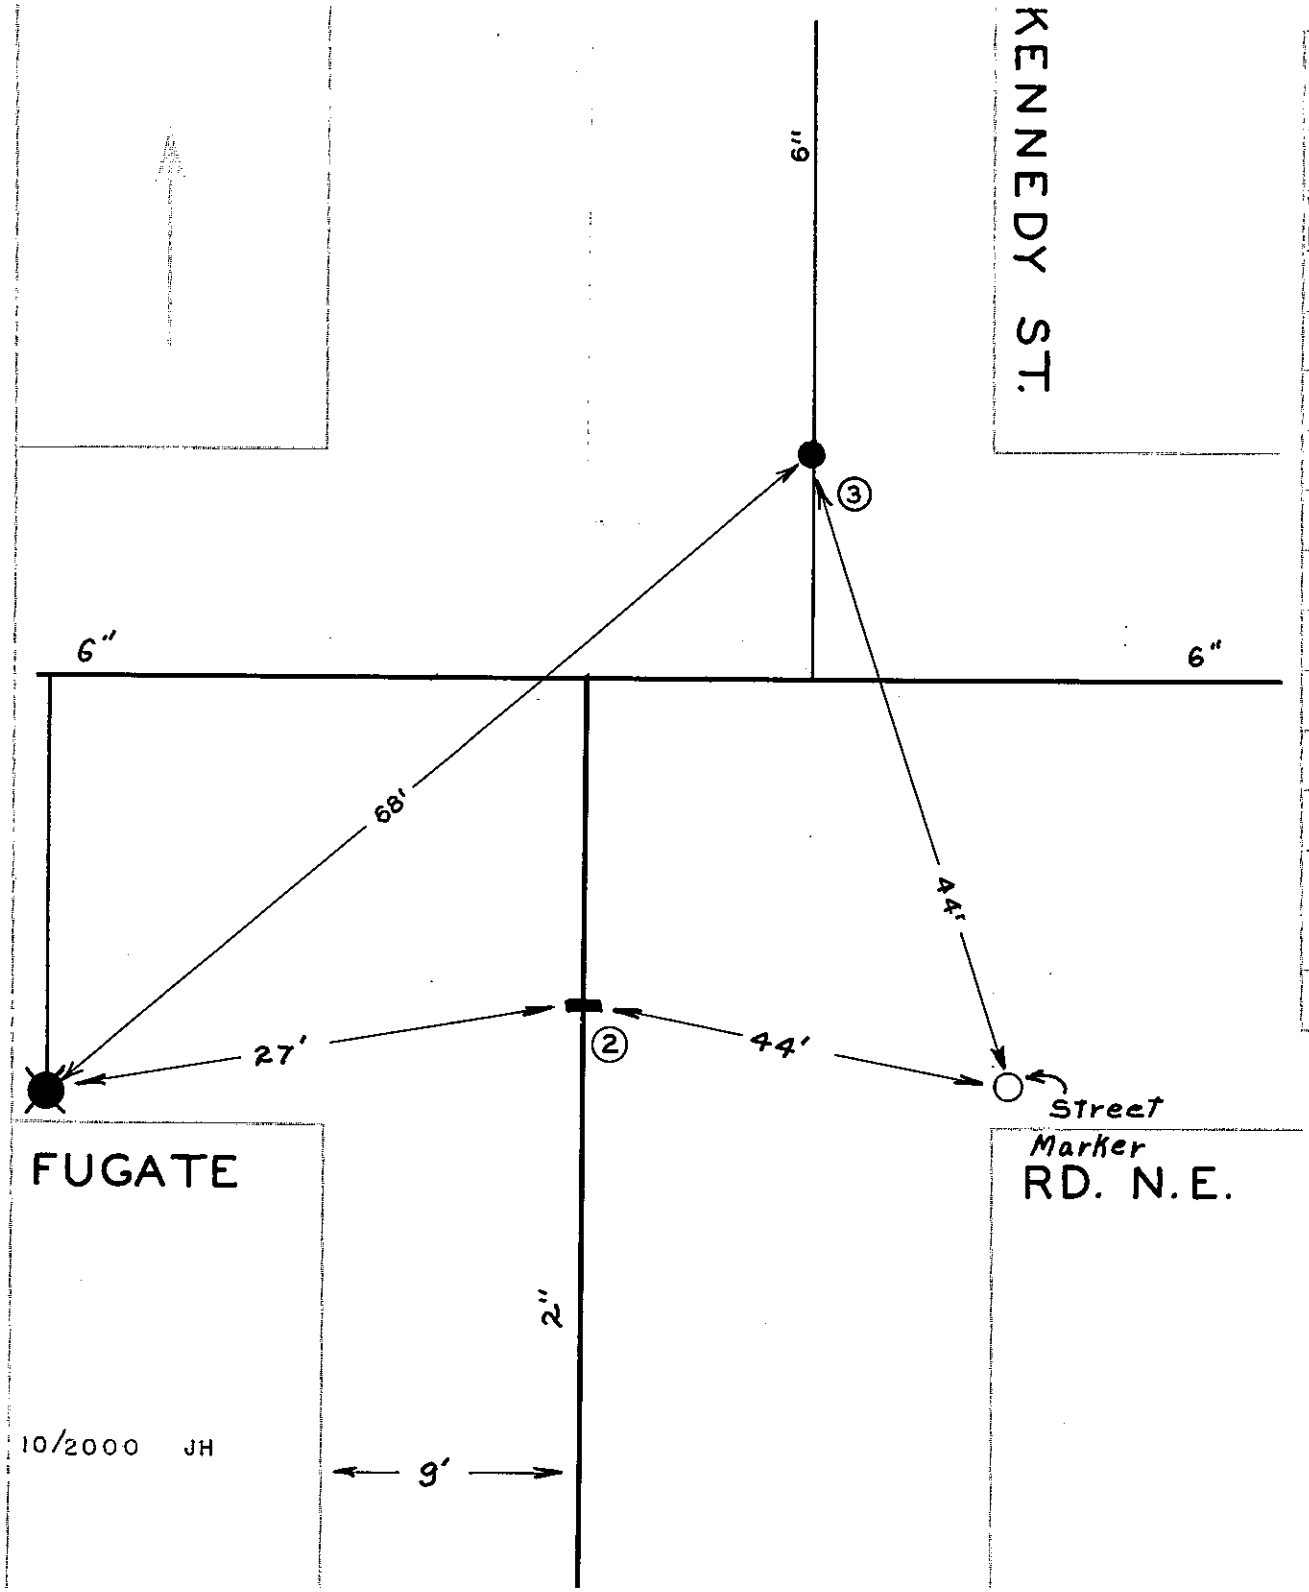

TYPE	NO	SIZE	MARKS	OPEN	TURNS
W R 1951	2	2"		R	
I-63	3	6"	MUELLER	R	
	2	11'-N	S P L		
	3	0	N.P.L.		

CITY OF ROANOKE - WATER DEPT
VALVE DIAGRAM

FUGATE ROAD &.
KENNEDY STREET

SEC MAP 310 NE

DATE PAGE NO.