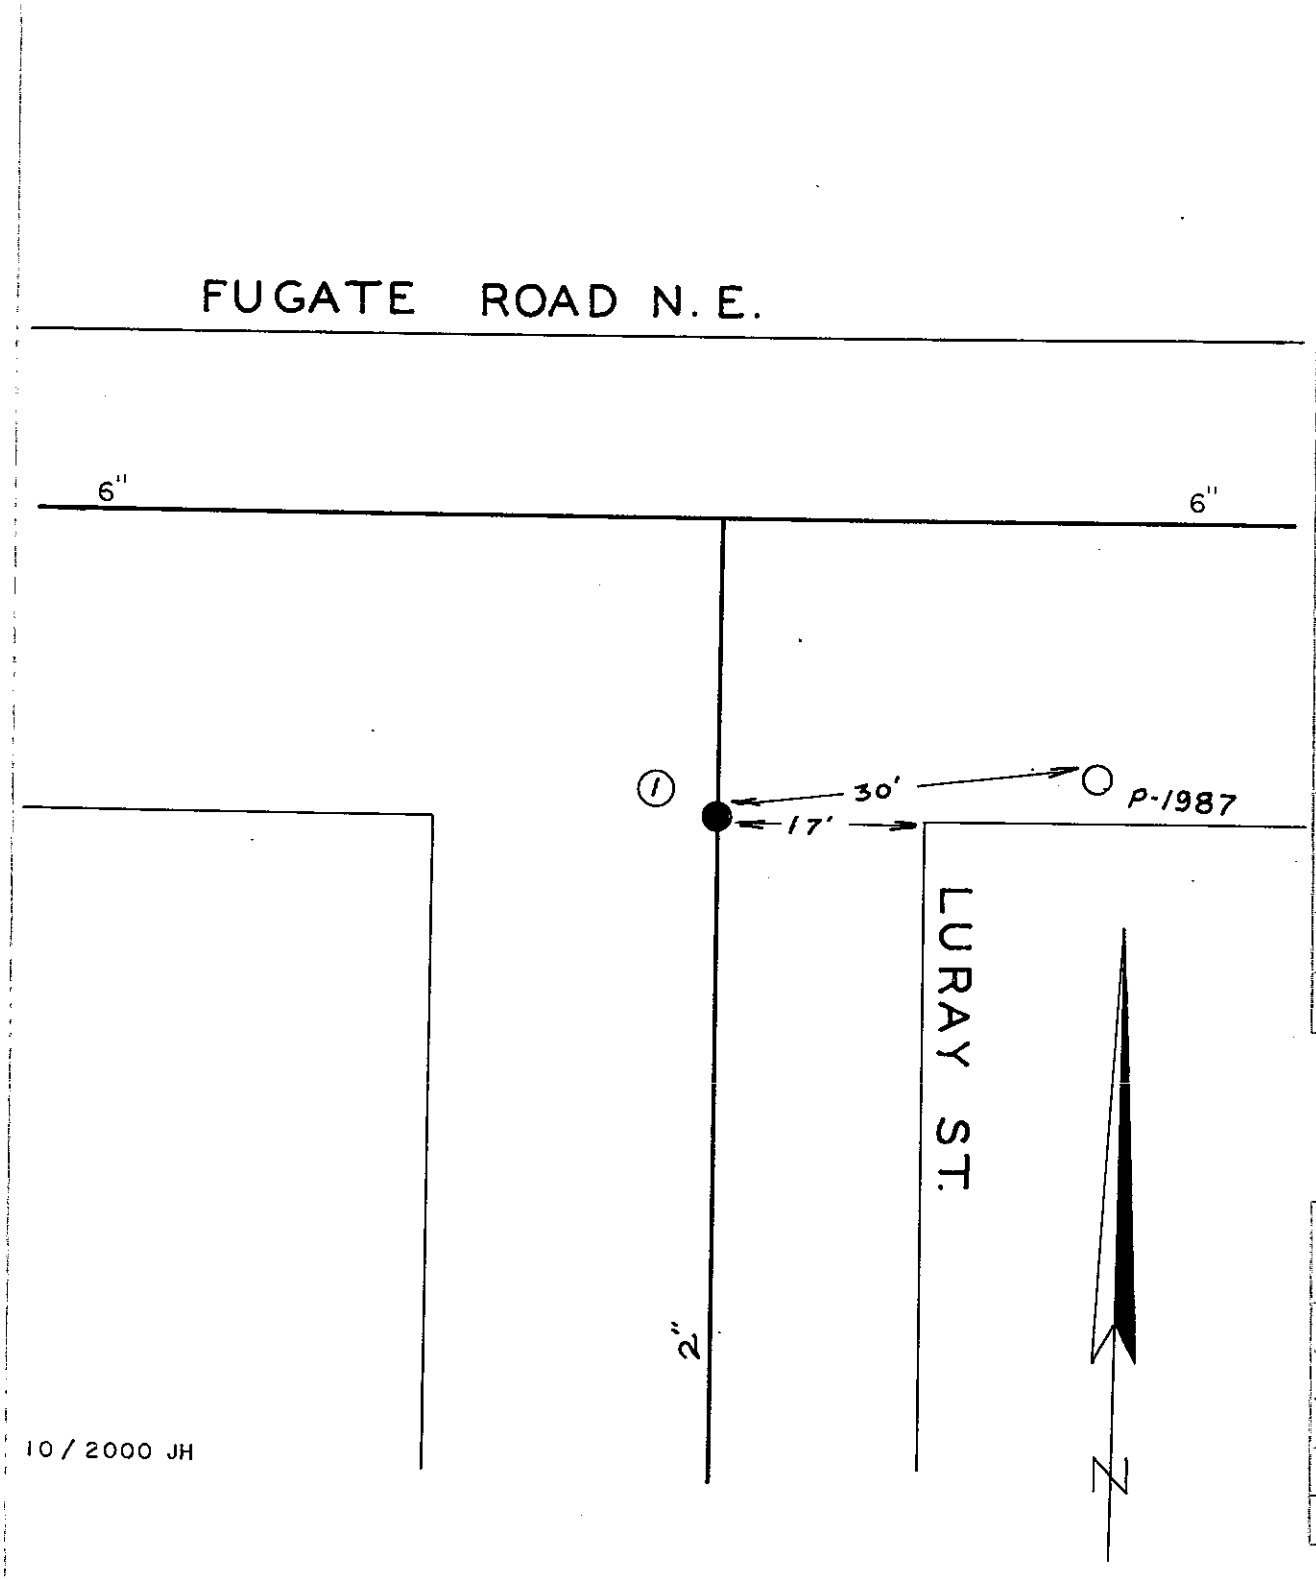

DATE	NO.	SIZE	MAKE	OPEN	TURNS
1955	1	2"	DARLING	R	7
	1	0	NPL		

CITY OF ROANOKE — WATER DEPT.

VALVE DIAGRAM

FUGATE RD. &

LURAY STREET

SEC. MAP 310, 313 N.E.

DATE PAGE NO.