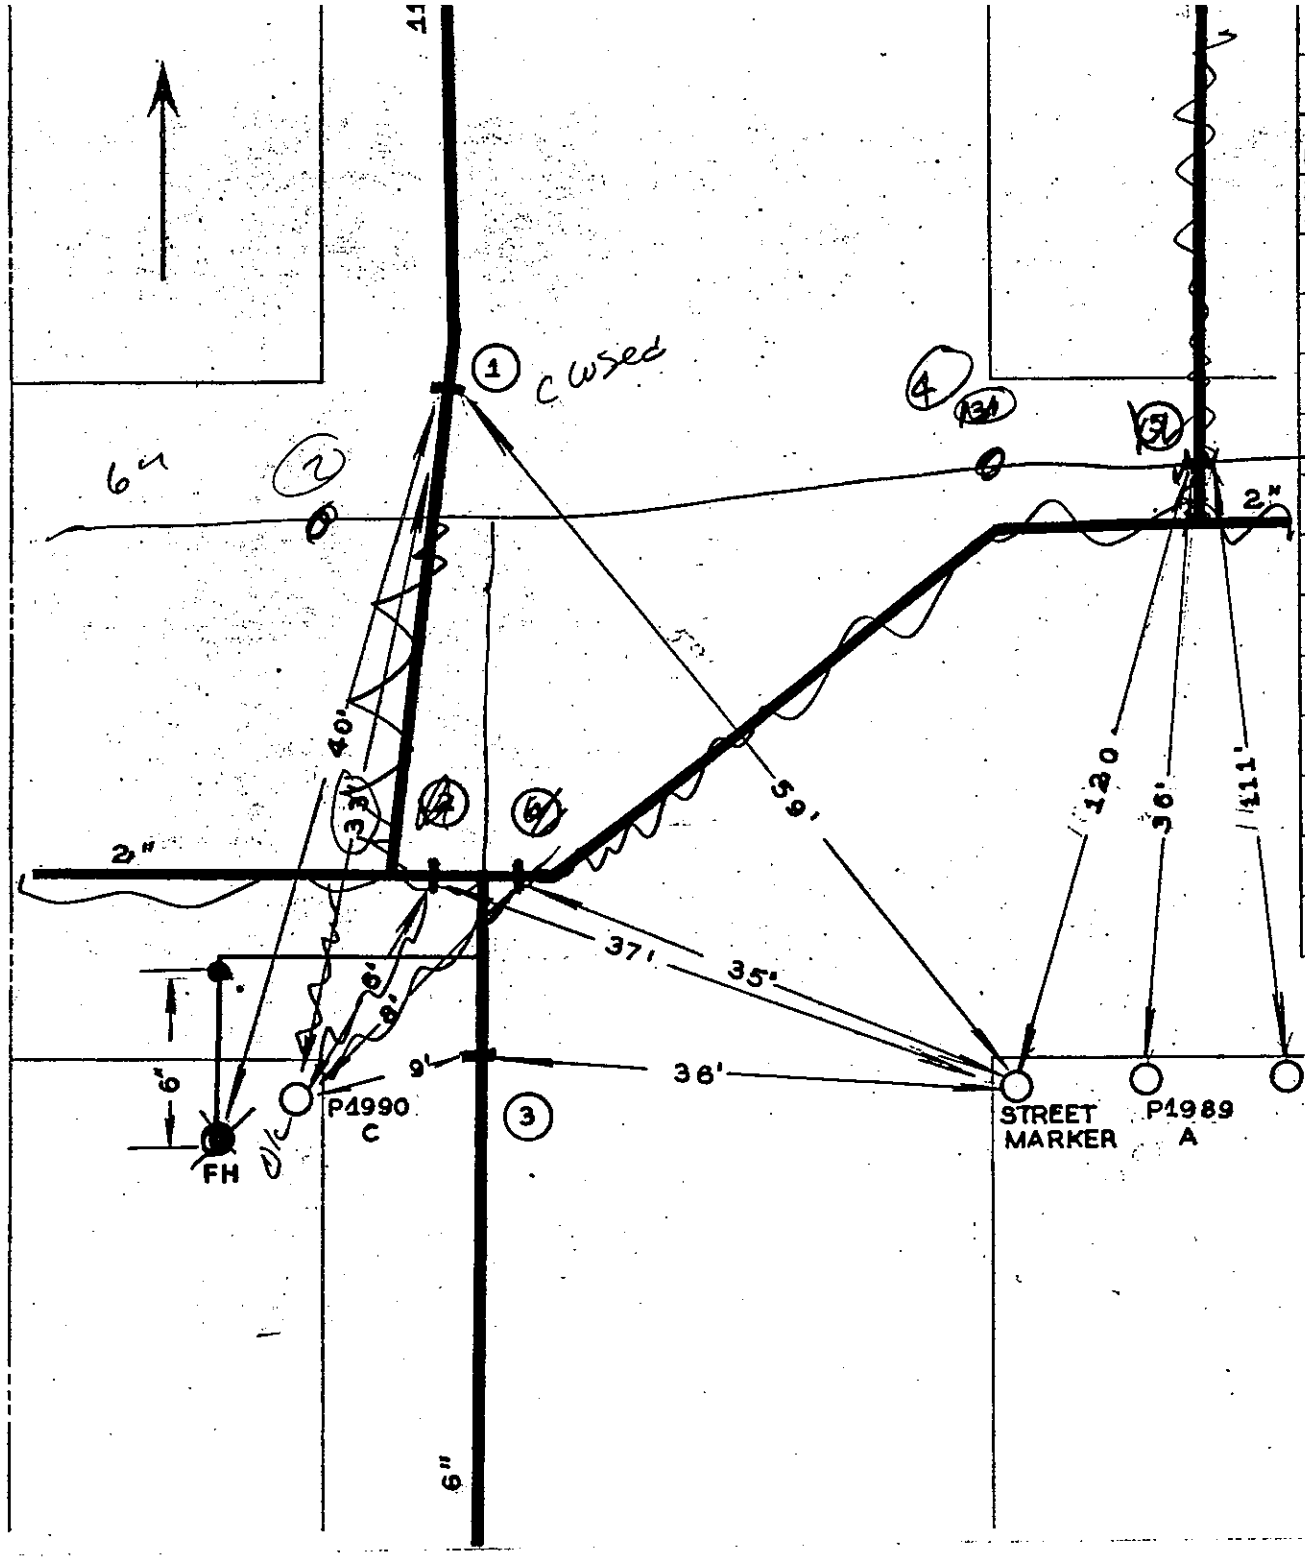

DATE	NO.	SIZE	MAKE	OPEN	TURNS
1951 WR	1	11CA			
1953	~~2~~	~~2"~~ 6"			
WR 1951	3	6"			
1953	~~4~~	~~2"~~ 6"			
	~~5~~	~~2"~~			

4/89 need marks

CITY OF ROANOKE—WATER DEP'T

VALVE DIAGRAM

FUGATE ROAD N.E. &

MANSFIELD ST. N. E.

SEC. MAP 310

DATE WR PAGE NO. NE 220