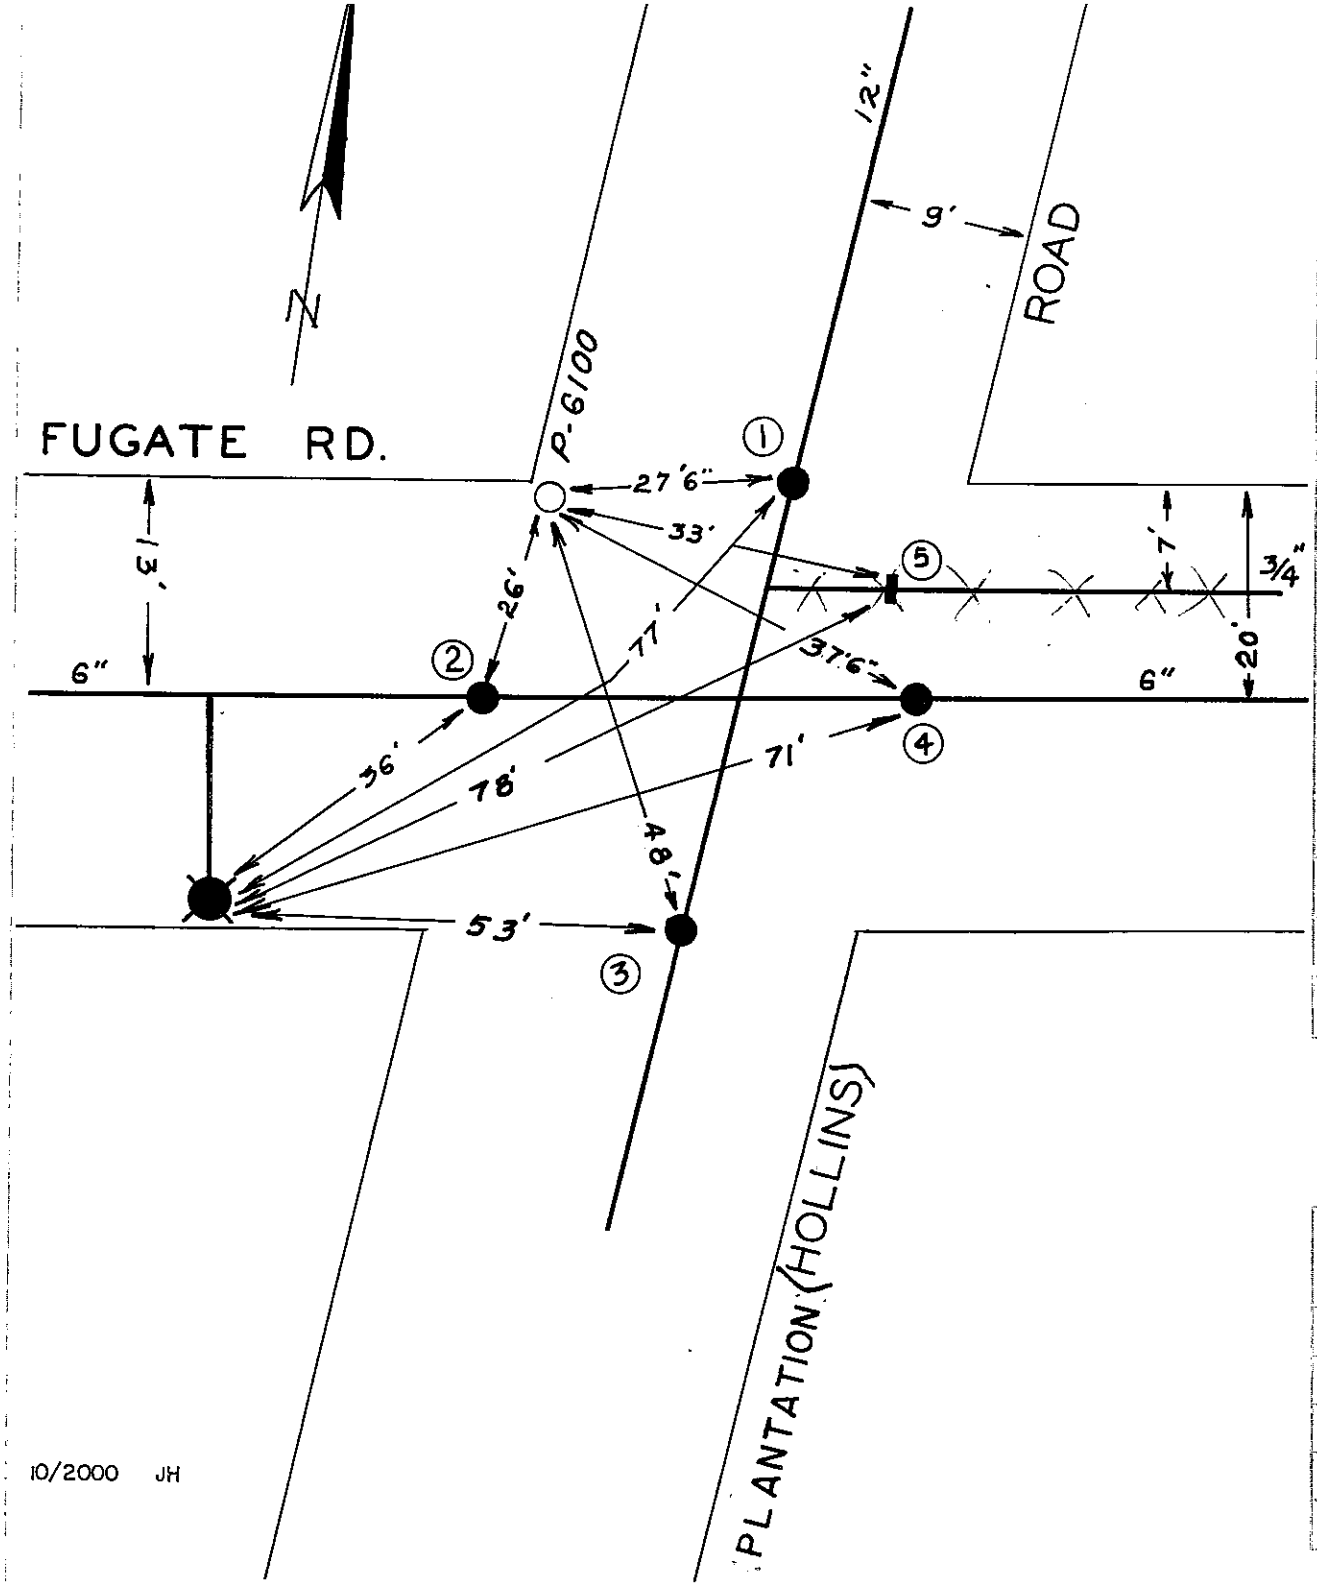

DATE	NO.	SIZE	MAKE	OPEN	TURNS
1953	1	12"	MUELLER	R	38
1953	2	6"	MUELLER	R	20
1953	3	12"	MUELLER	R	38
1953	4	6"	MUELLER	R	20
~~1953~~	~~5~~	~~3/4"~~			
	1	0	N PL		
	2	0	W PL		
	3	0	S PL		
	4	0	E PL		
	5	3'-W	E PL		

CITY OF ROANOKE – WATER DEPT.

VALVE DIAGRAM

FUGATE RD. &

PLANTATION ROAD

SEC. MAP 310, 313 N.E.

DATE PAGE NO.

10/2000 JH