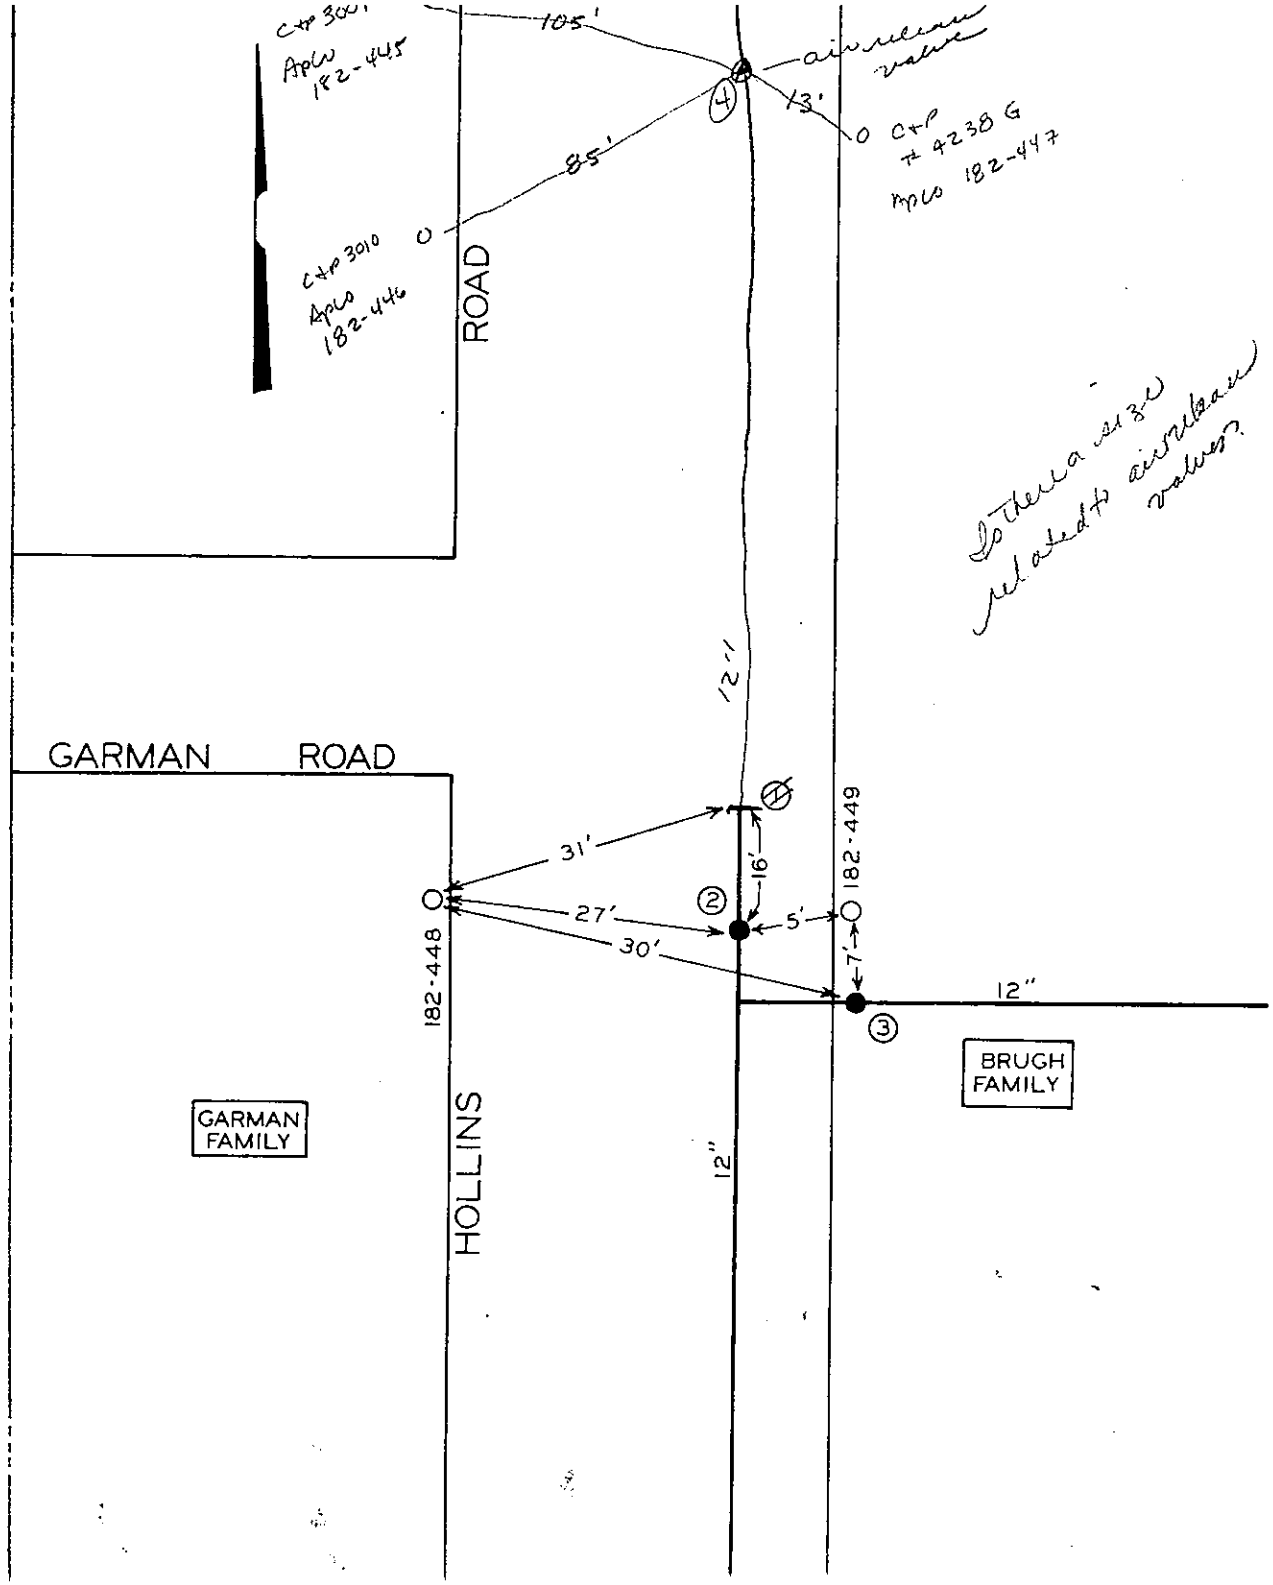

Is there a valve related to air release valve?

DATE	NO.	SIZE	MAKE	OPEN	TURNS
~~68~~	~~1~~	~~2"~~	~~MISC.~~	~~L~~	
68	2	12"	DARLING	R	
68	3	12"	DARLING	R	
1987	4	1"	air release valve		
	~~1~~	~~17' S~~	~~GARMAN RD.~~	just draw a line here - shows where	
	2	35' S	GARMAN RD.	main valve stops	

CITY OF ROANOKE—WATER DEP'T

VALVE DIAGRAM

GARMAN ROAD & HOLLINS ROAD N.E.

SEC. MAP 73

DATE JUL 9 1971 PAGE NO.