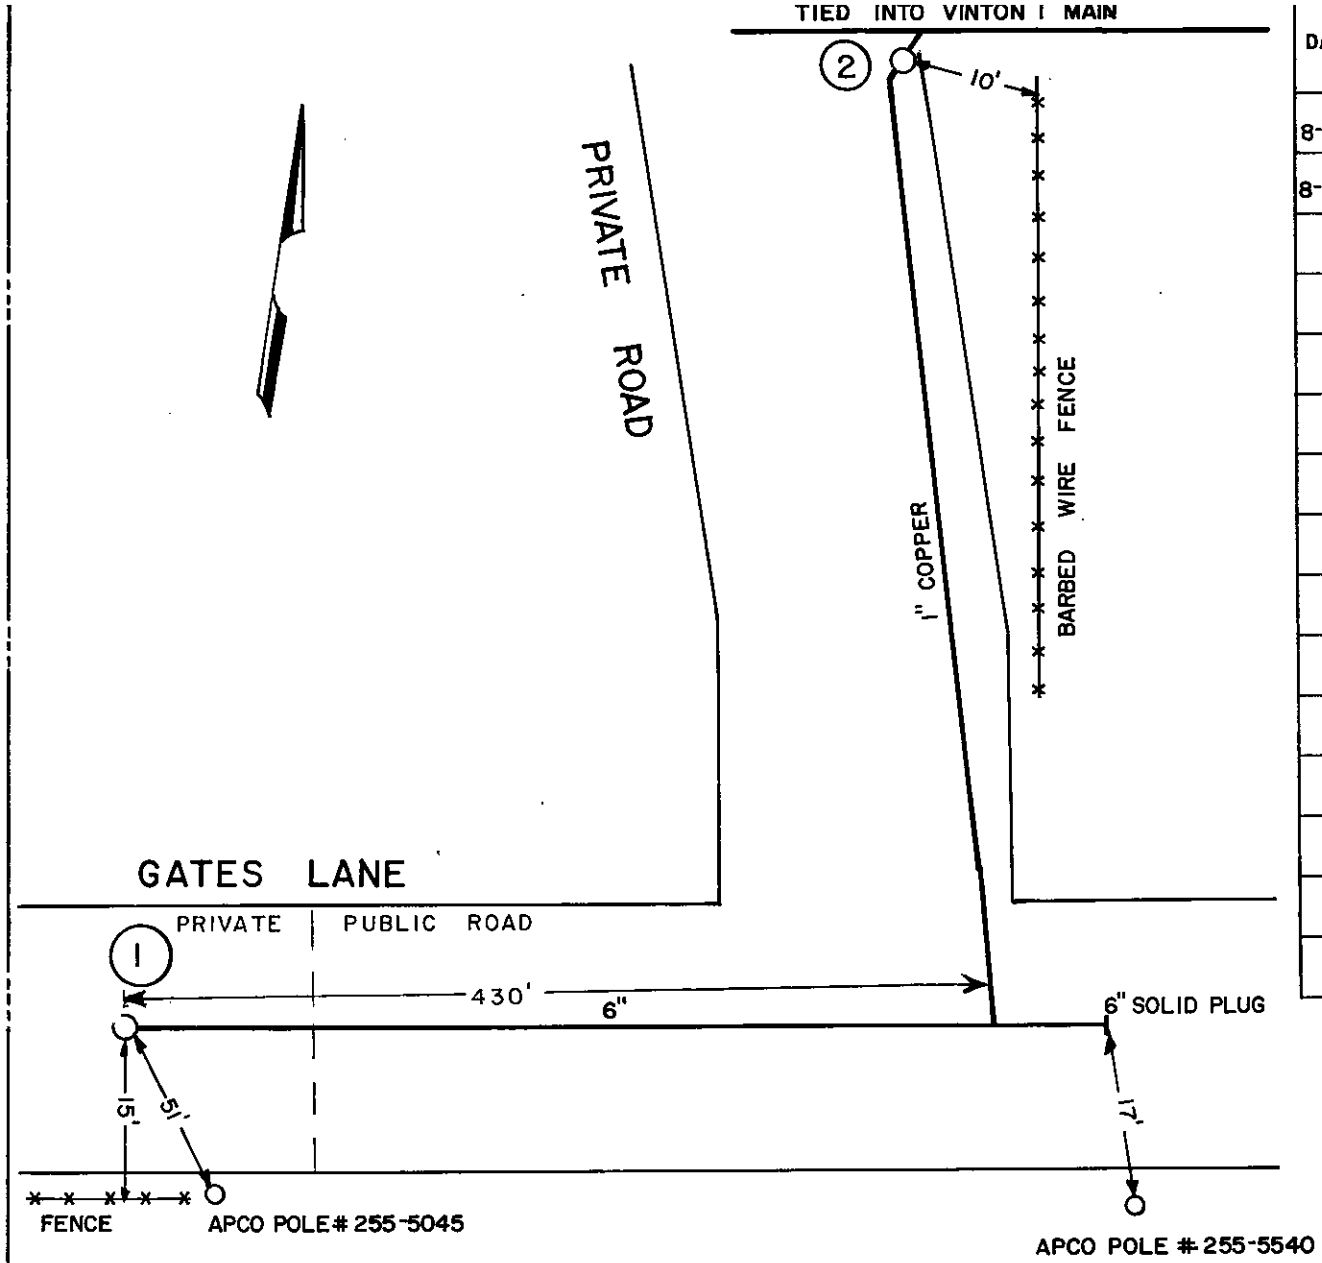

DATE	NO.	SIZE	MAKE	OPEN	TURNS
8-1-86	1	2"	BLOW OFF	L	
8-1-86	2	1"	#1 BOX	L	

10/2000 JH

1/88 NP

CITY OF ROANOKE—WATER DEP'T

VALVE DIAGRAM

GATES LANE

N.E.

SEC. MAP 702

DATE PAGE NO.