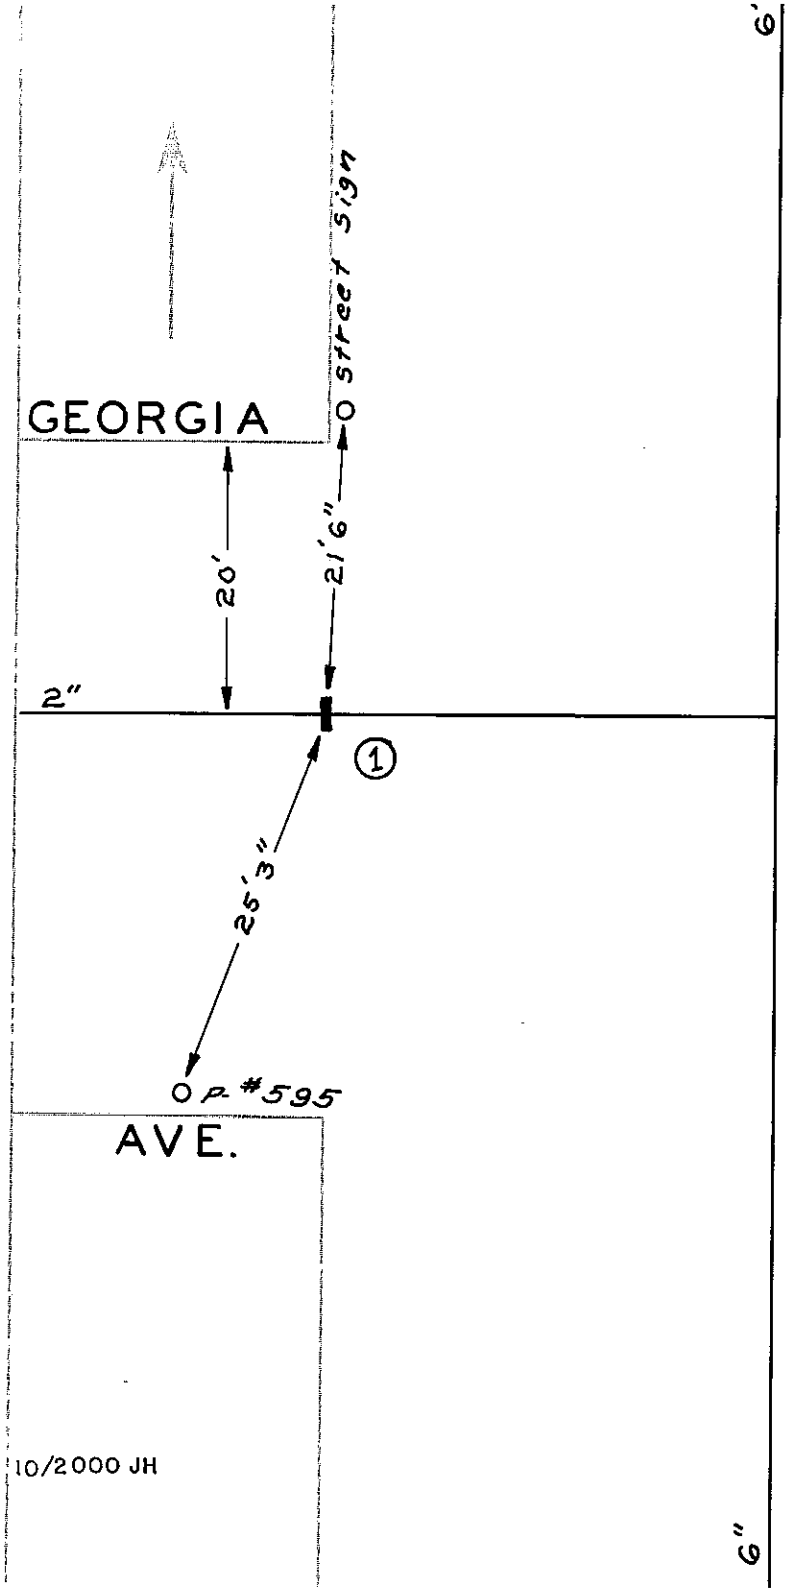

10TH. STREET

DATE	NO.	SIZE	NAME	OPEN	TURNS
'58	1	2"	MISC.		
	1	0	WPL		

CITY OF ROANOKE--WATER DEPT
VALVE DIAGRAM

GEORGIA AVE. &
10 th. STREET

SEC. MAP 306 N. E.

DATE PAGE NO