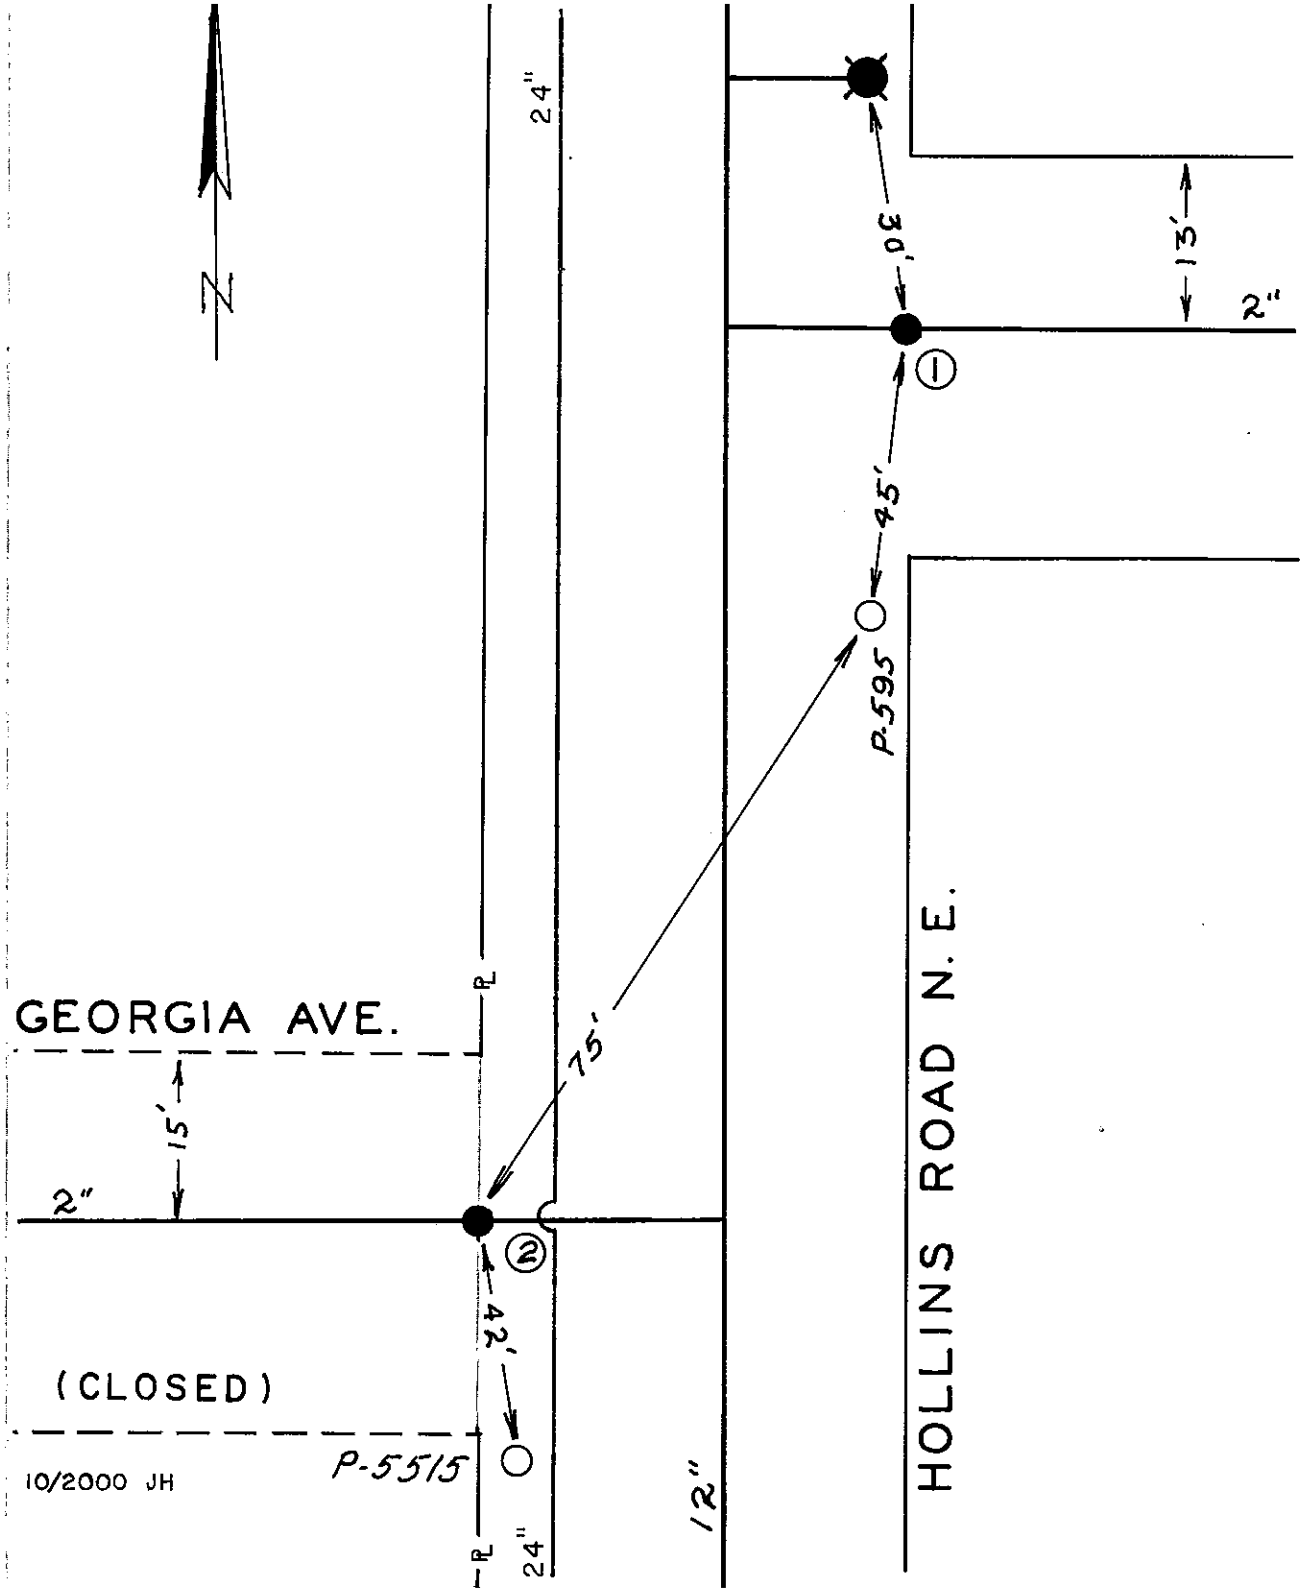

DATE	NO.	SIZE	MAKE	OPEN	TURNS
1944	1	2"		R	
1925	2	2"		R	
	1	0	EPL		
	2	0	WPL		

CITY OF ROANOKE — WATER DEPT.

VALVE DIAGRAM

GEORGIA AVE. &

HOLLINS ROAD

SEC. MAP 306 N.E.

DATE PAGE NO.