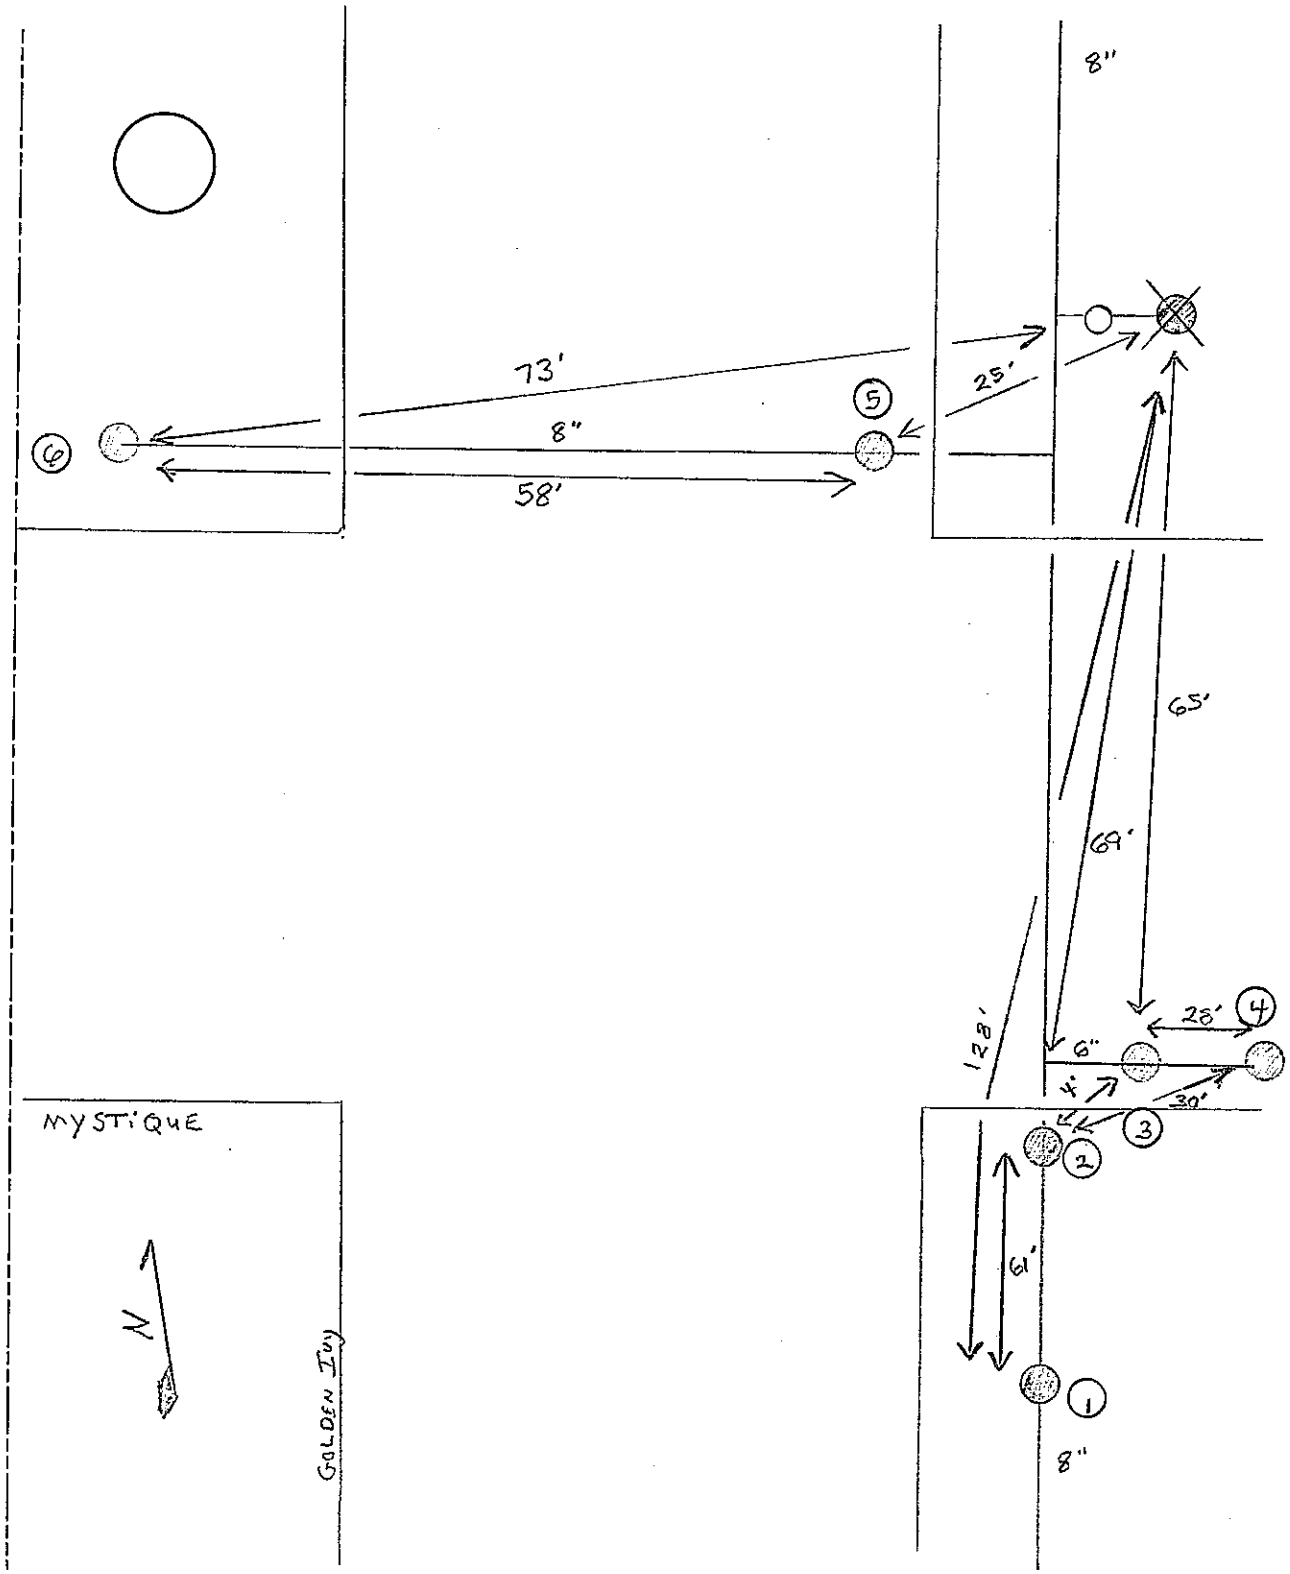

DATE	NO.	SIZE	MAKE	OPEN	TURNS
2004	1		AIR RELEASE		
2004	2	8"	AMERICAN	L	27
2004	3	6"	AMERICAN	L	21
2004	4	6"	BLOWOFF		
2004	5	8"	AMERICAN	L	27
2004	6	8"	BLOWOFF		

WESTERN VIRGINIA WATER AUTHORITY

VALVE DIAGRAM

GOLDEN IVY AND MYSTIQUE

SECT. MAP COUNTY

8-18-04