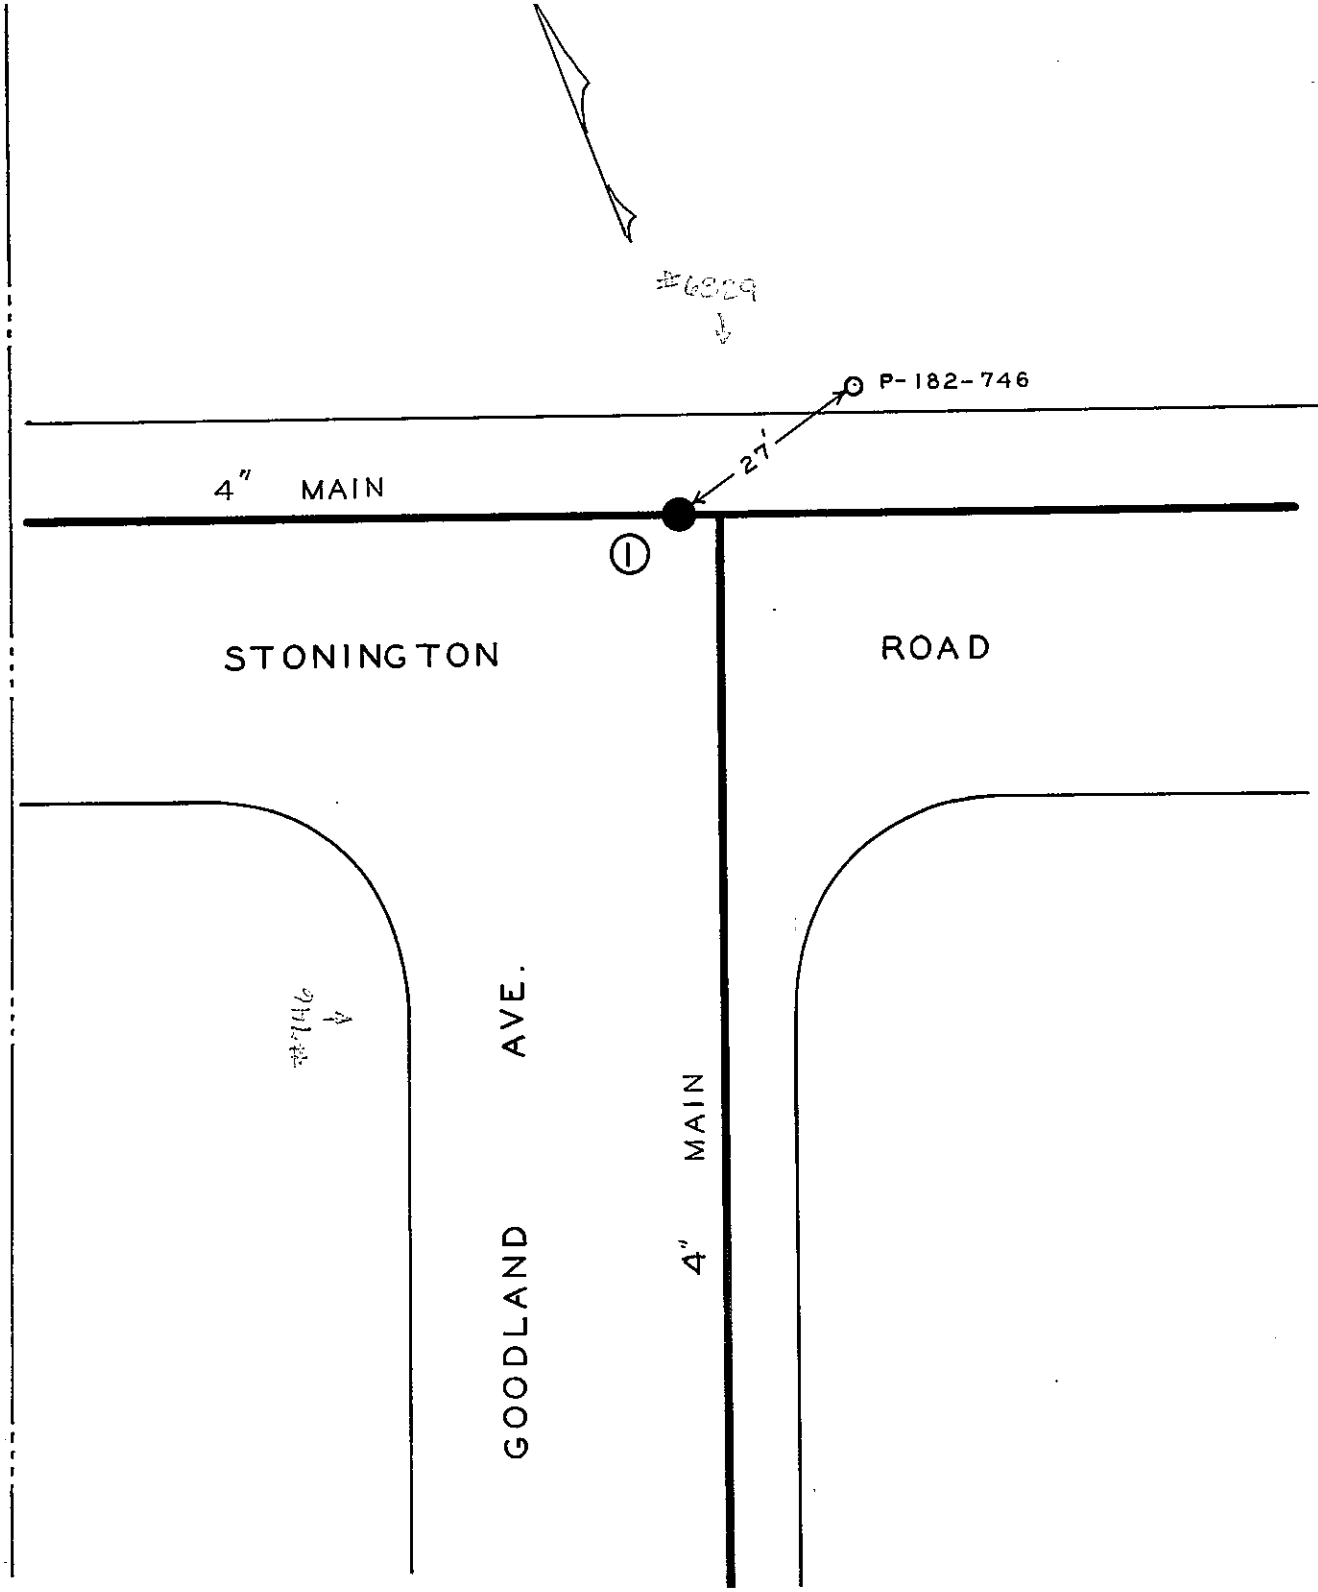


| DATE | NO. | SIZE | MAKE | OPEN | TURNS |
|---|---|---|---|---|---|
| | 1 | 4" | DAR. | L | |
| | | | | | |
| | | | | | |
**CITY OF ROANOKE—WATER DEPT.**

**VALVE DIAGRAM**

GOODLAND AVE. &

STONINGTON RD N.E.

**SEC. MAP** 59 Roanoke County

**DATE** 9-7-66 **PAGE NO.**