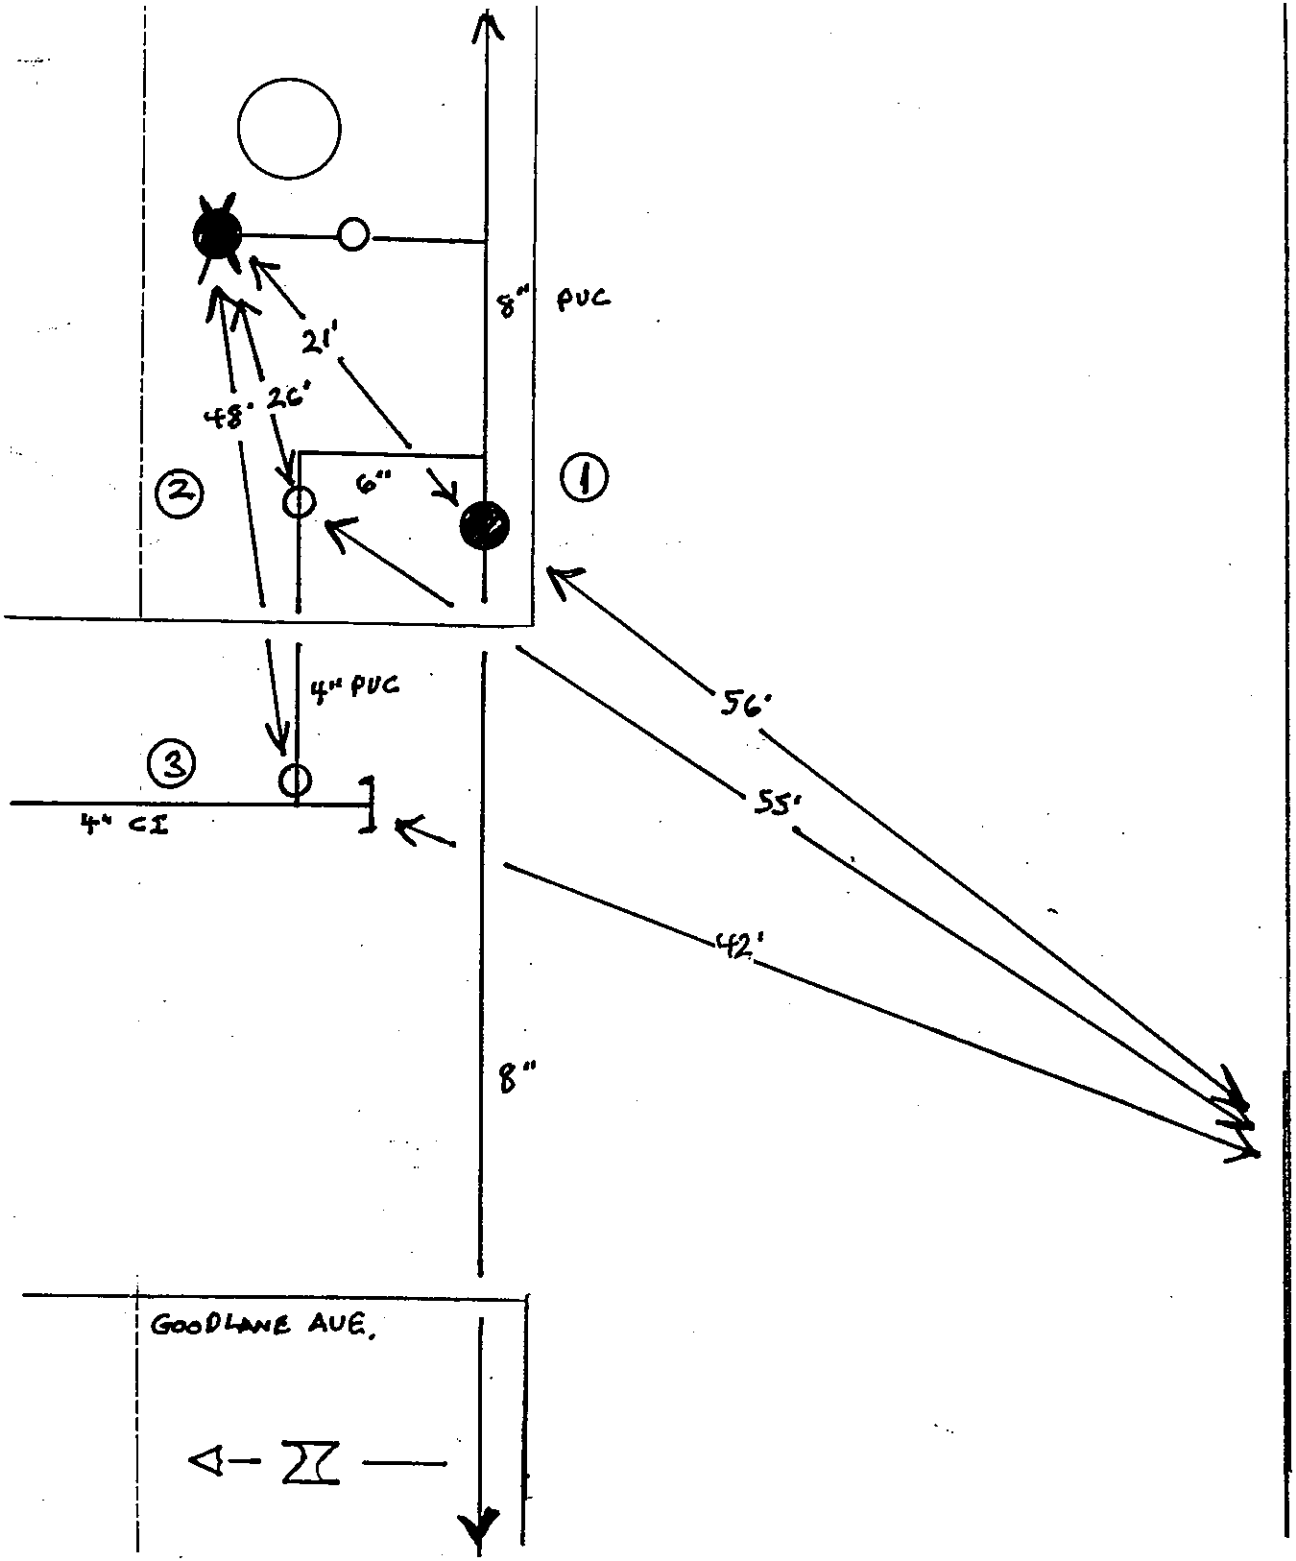

DATE	NO.	SIZE	MAKE	OPEN	TURNS
8/08	1	8"	KENNEDY	L	27
8/08	2	6"	KENNEDY	L	21
8/08	3	4"	MUELLER	L	15

WESTERN VIRGINIA WATER AUTHORITY

VALVE DIAGRAM

GOODLAND AVE AND
TREVILIAN ROAD NE.

SECT. MAP

DATE 8-13-08