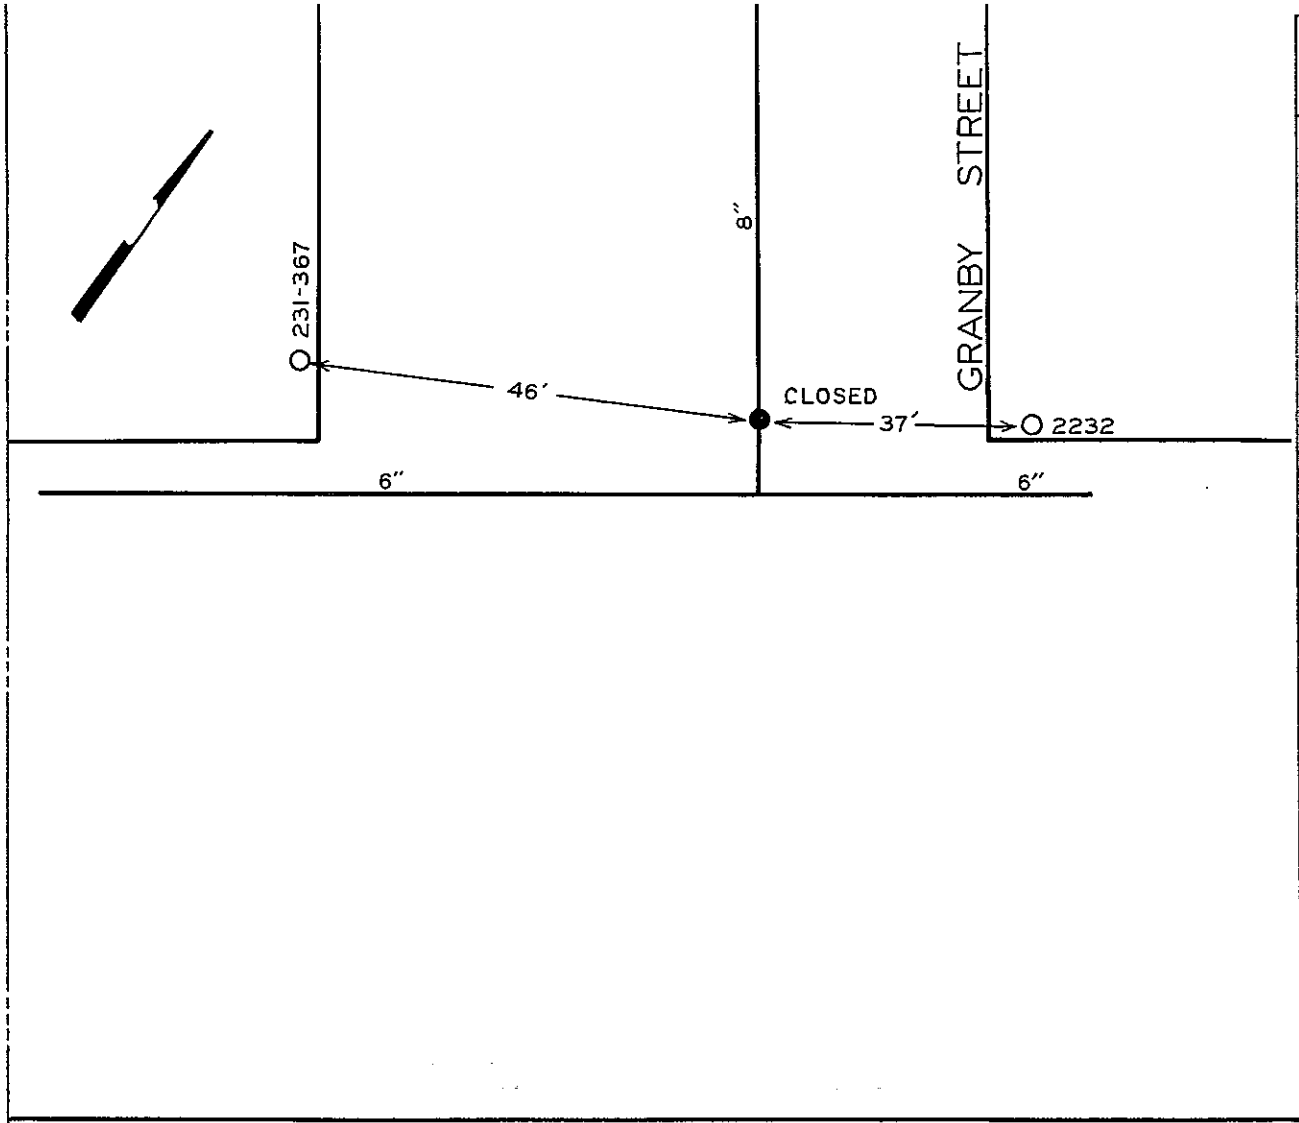

DATE	NO.	SIZE	MAKE	OPEN	TURNS
69	1	6"	MUELLER	R	20

CITY OF ROANOKE—WATER DEP'T

VALVE DIAGRAM

GRANBY ST. &

ORANGE AVE. (RTE.460)

SEC. MAP 760 N. E.

DATE PAGE NO.

10/2000 JH