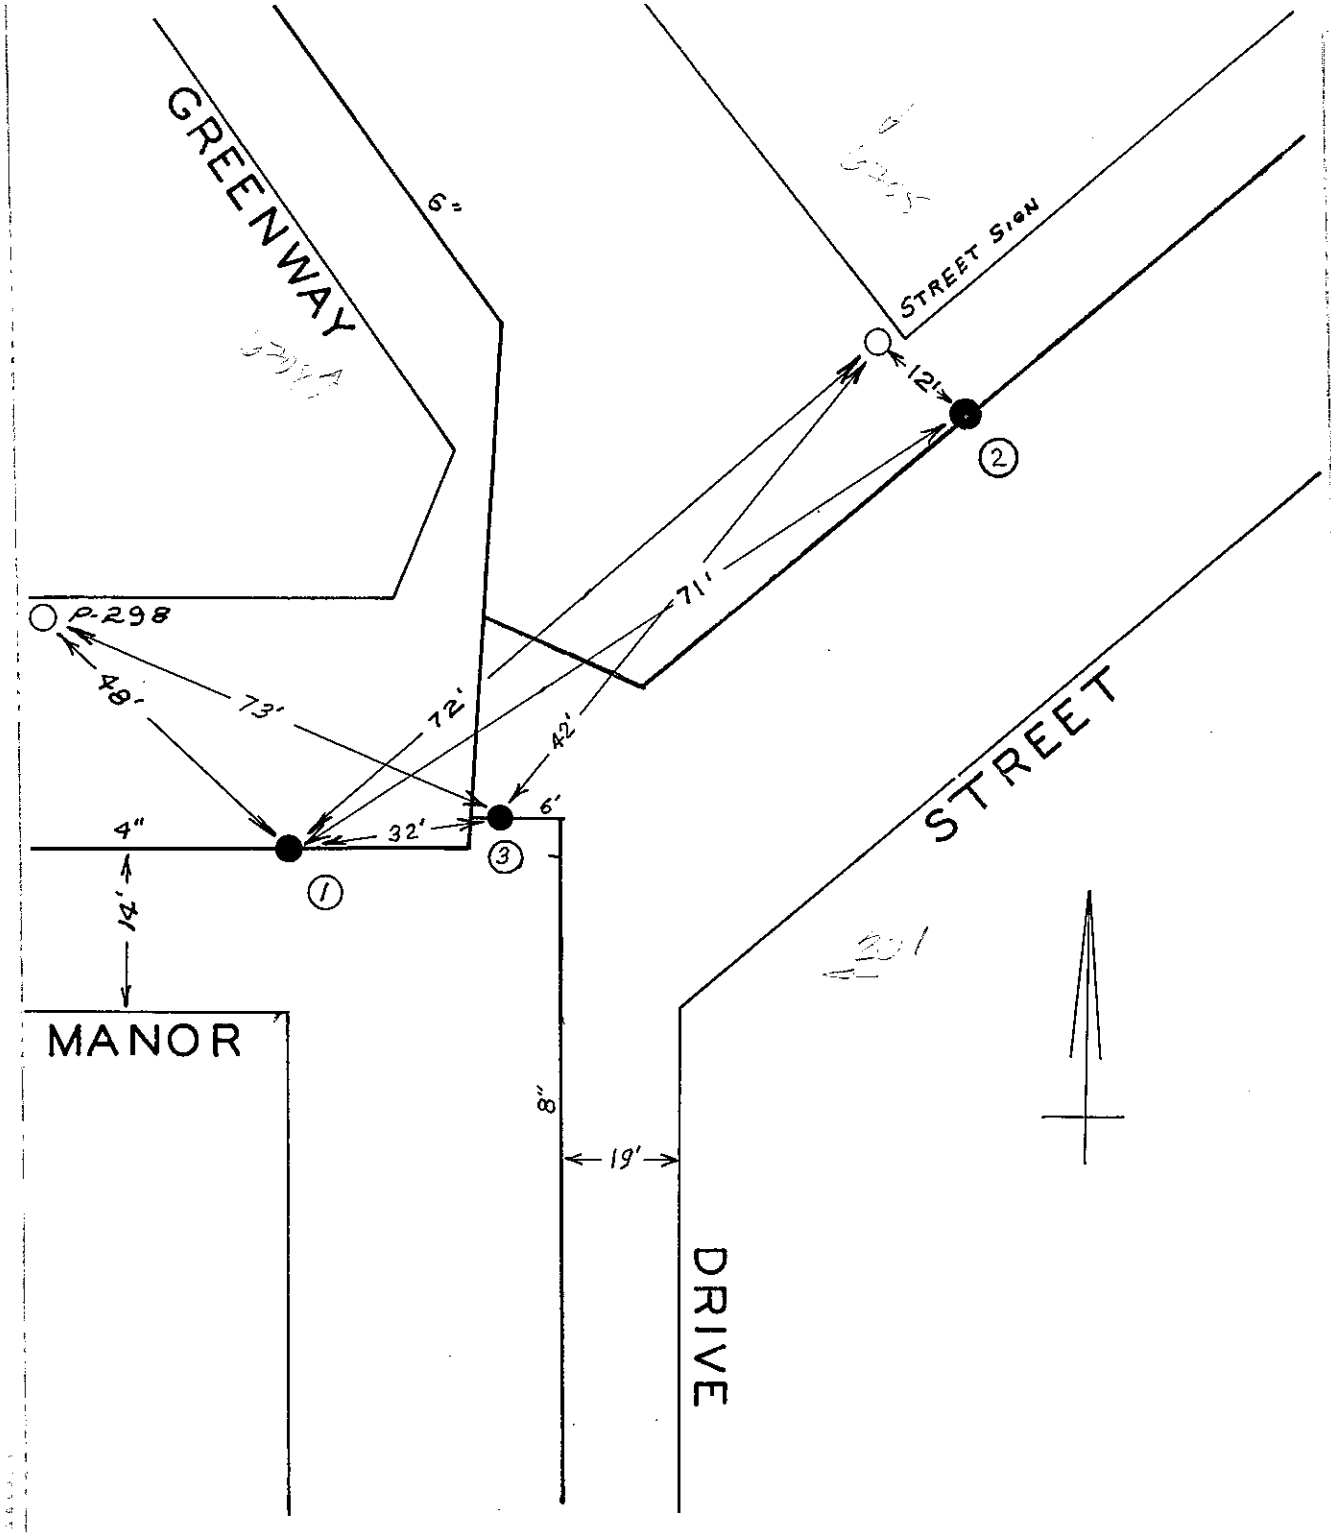

DATE	P.O.	SIZE	MAKER	OPEN	VERTICAL
	1	4"			
12-62	2	6"	MUELLER	R	20
12-68	3	6	MUELLER	R	20
	1	0	WPL		

GREENWAY DR. &
MANOR ST. N.E.

16 Roanoke County