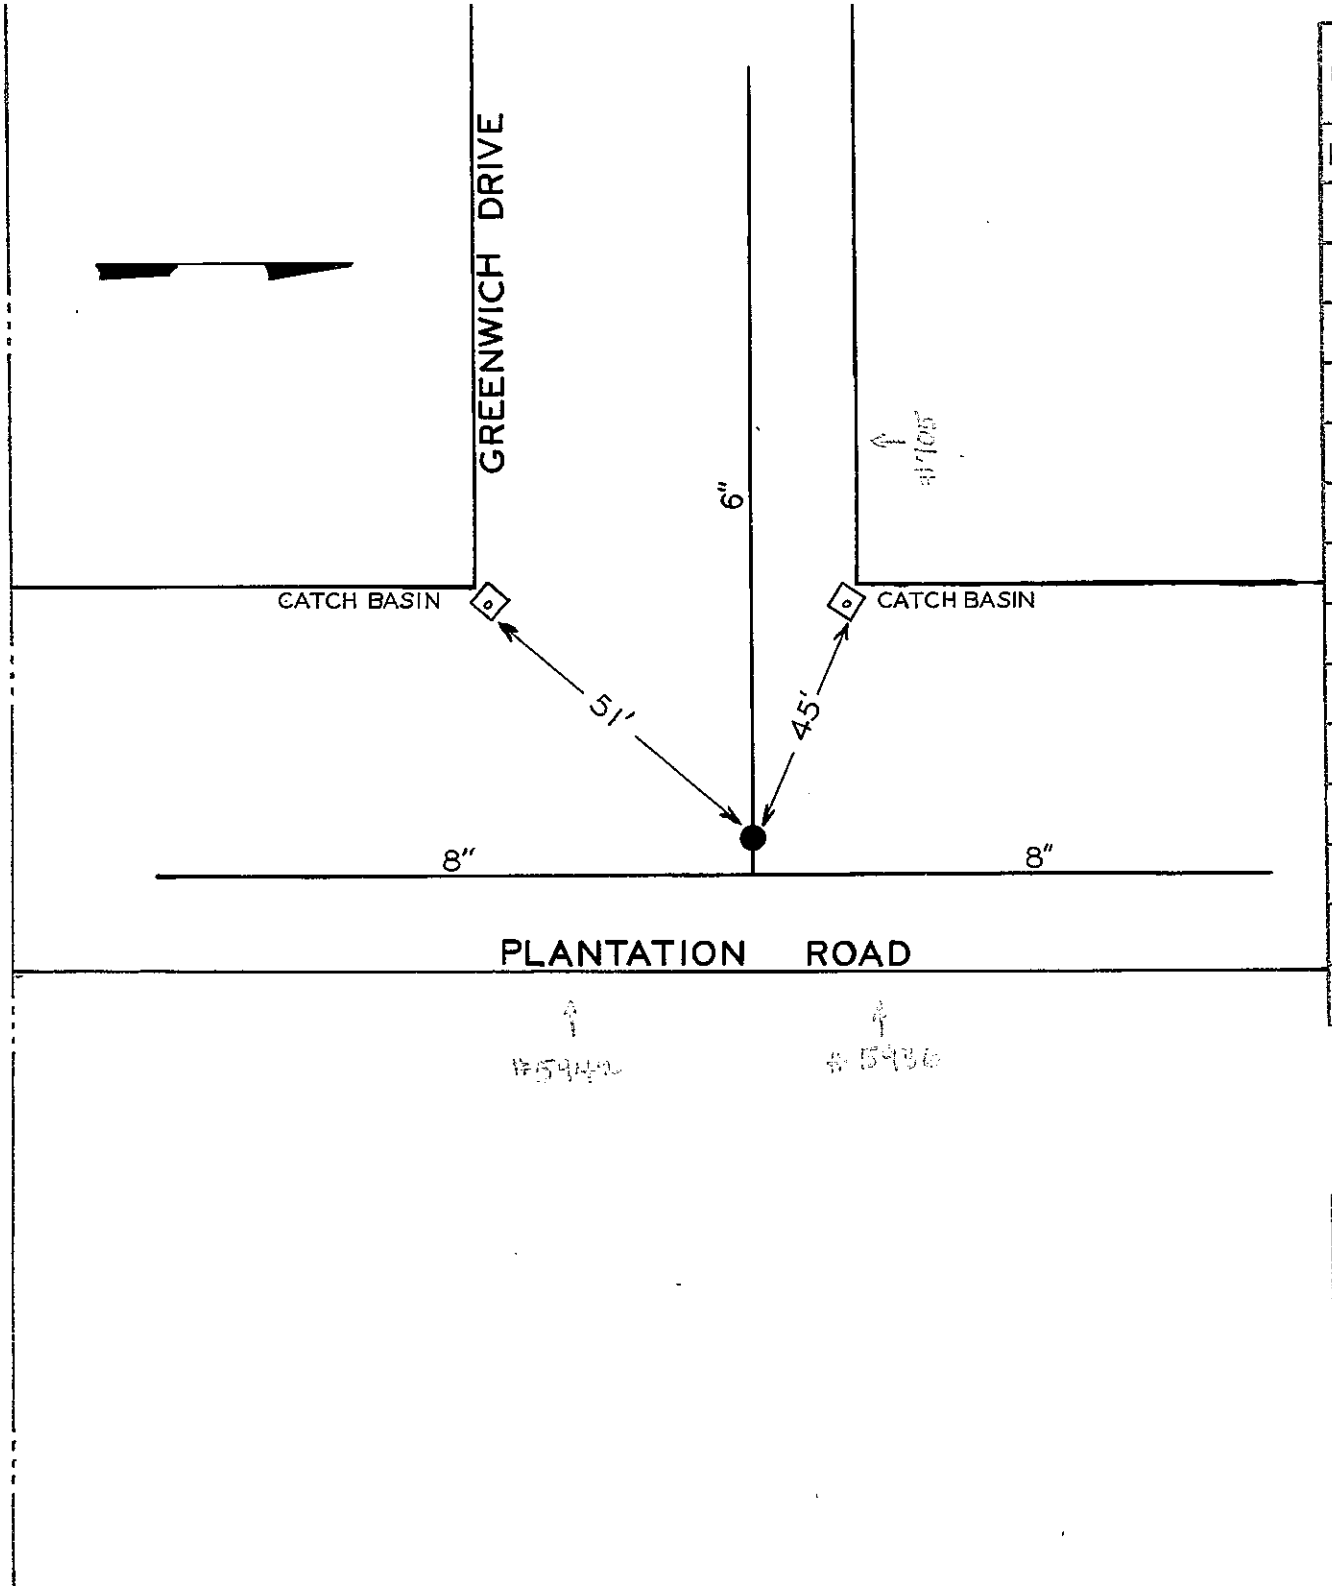

DATE	NO.	SIZE	MAKE	OPEN	TURNS
12-67	1	6	MUELLER	R	

CITY OF ROANOKE—WATER DEPT.

VALVE DIAGRAM

GREENWICH DRIVE &

PLANTATION ROAD N.E.

North Intersection

SEC. MAP 51 Roanoke County

DATE PAGE NO.