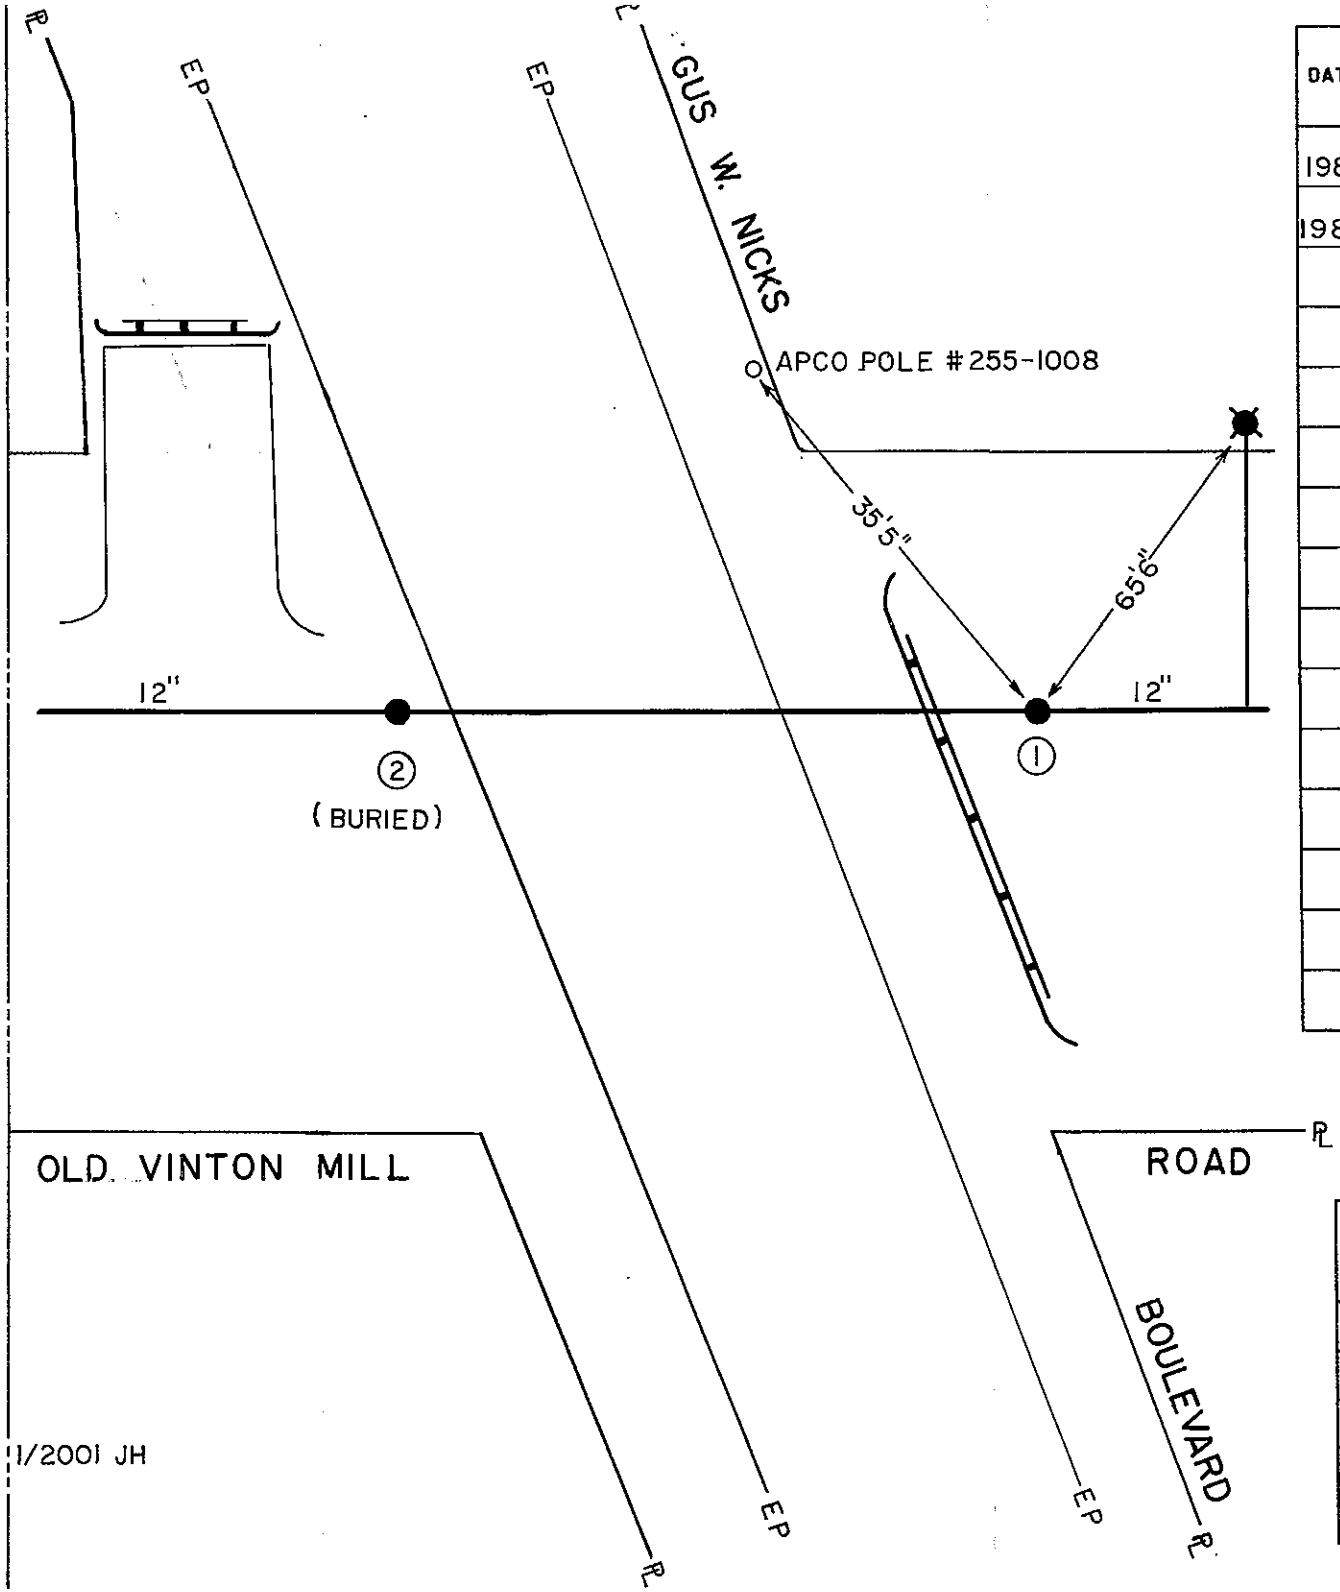

DATE	NO.	SIZE	MAKE	OPEN	TURNS
1981	1	12"			
1981	2	12"			

1/2001 JH

CITY OF ROANOKE—WATER DEP'T

VALVE DIAGRAM

GUS W. NICKS BLVD. &

OLD VINTON MILL ROAD

SEC. MAP 332, 341 N.E.

DATE PAGE NO.