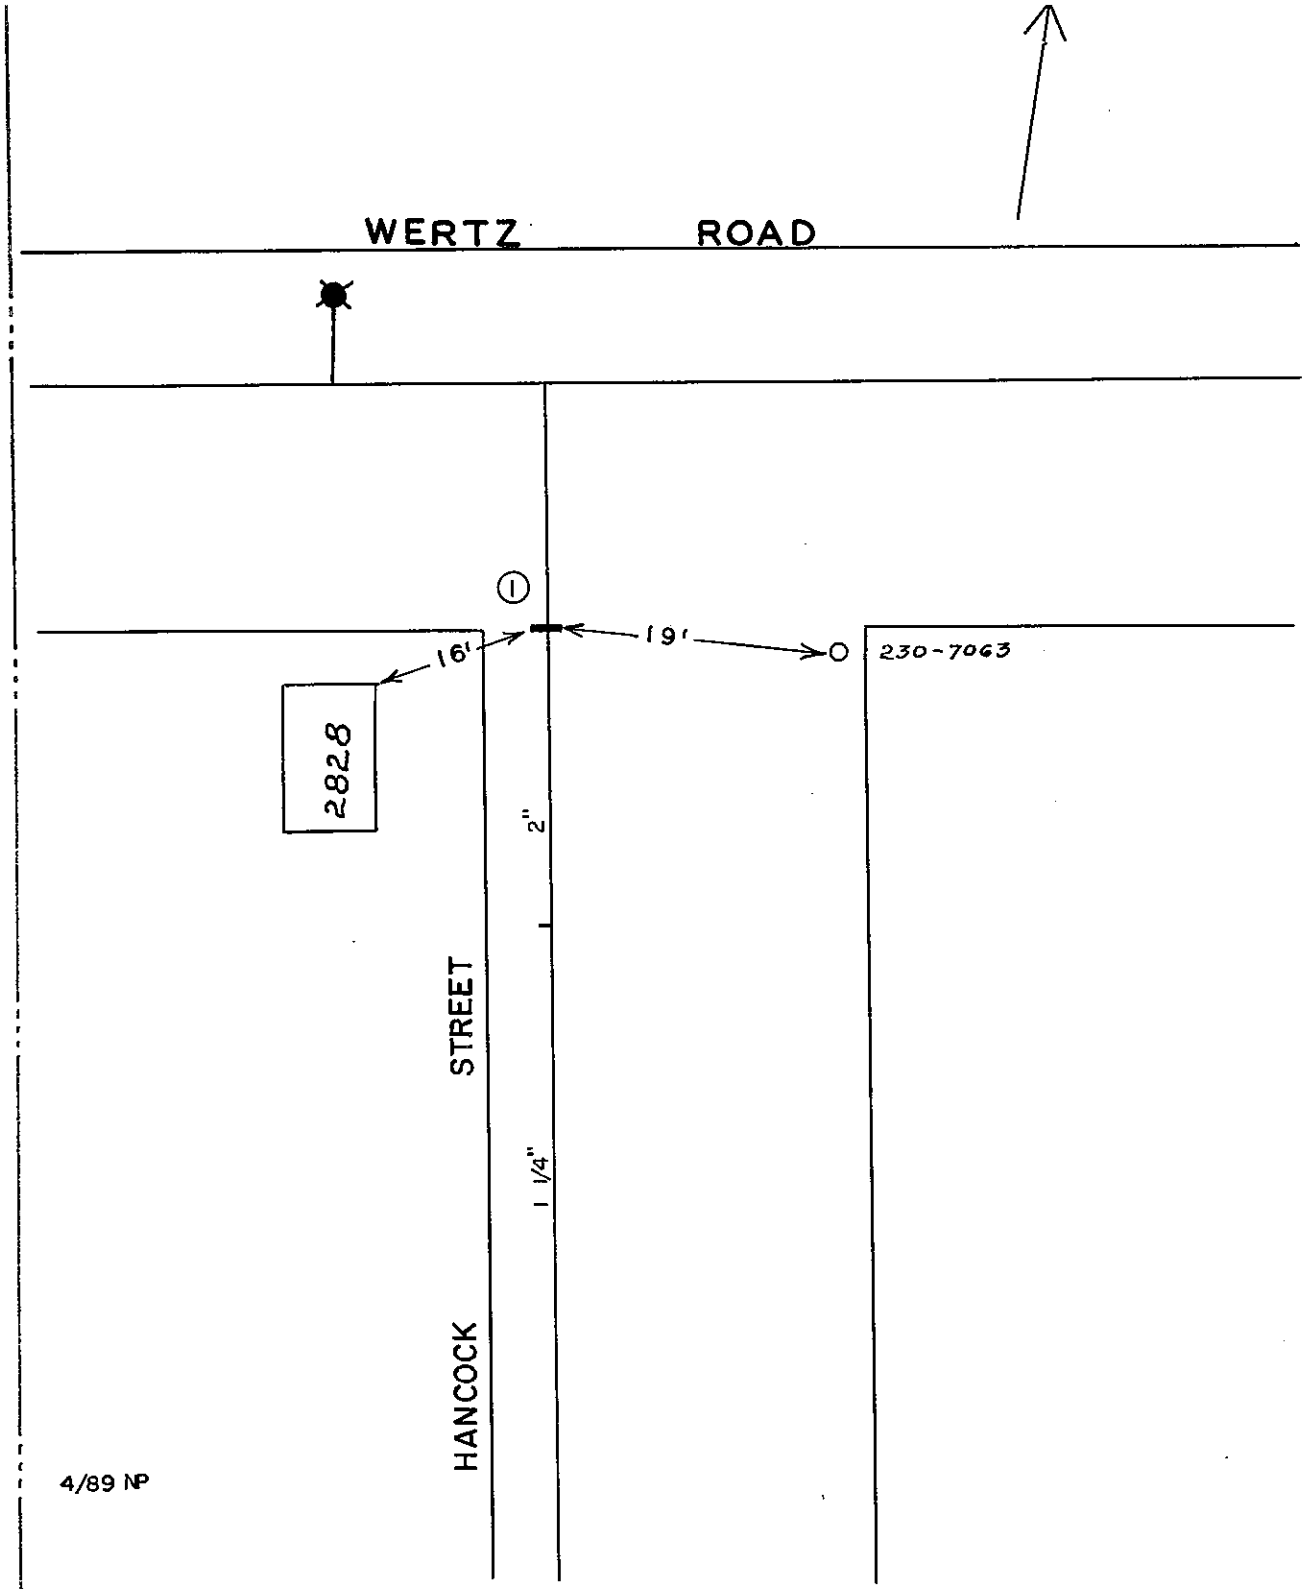

DATE	NO.	SIZE	MAKE	OPEN	TURNS
4-62	1	2"	DARLING	R	7
	1	0	S.P.L.		

CITY OF ROANOKE—WATER DEPT.

VALVE DIAGRAM

HANCOCK STREET &

WERTZ ROAD N.E.

SEC. MAP 314

DATE PAGE NO.