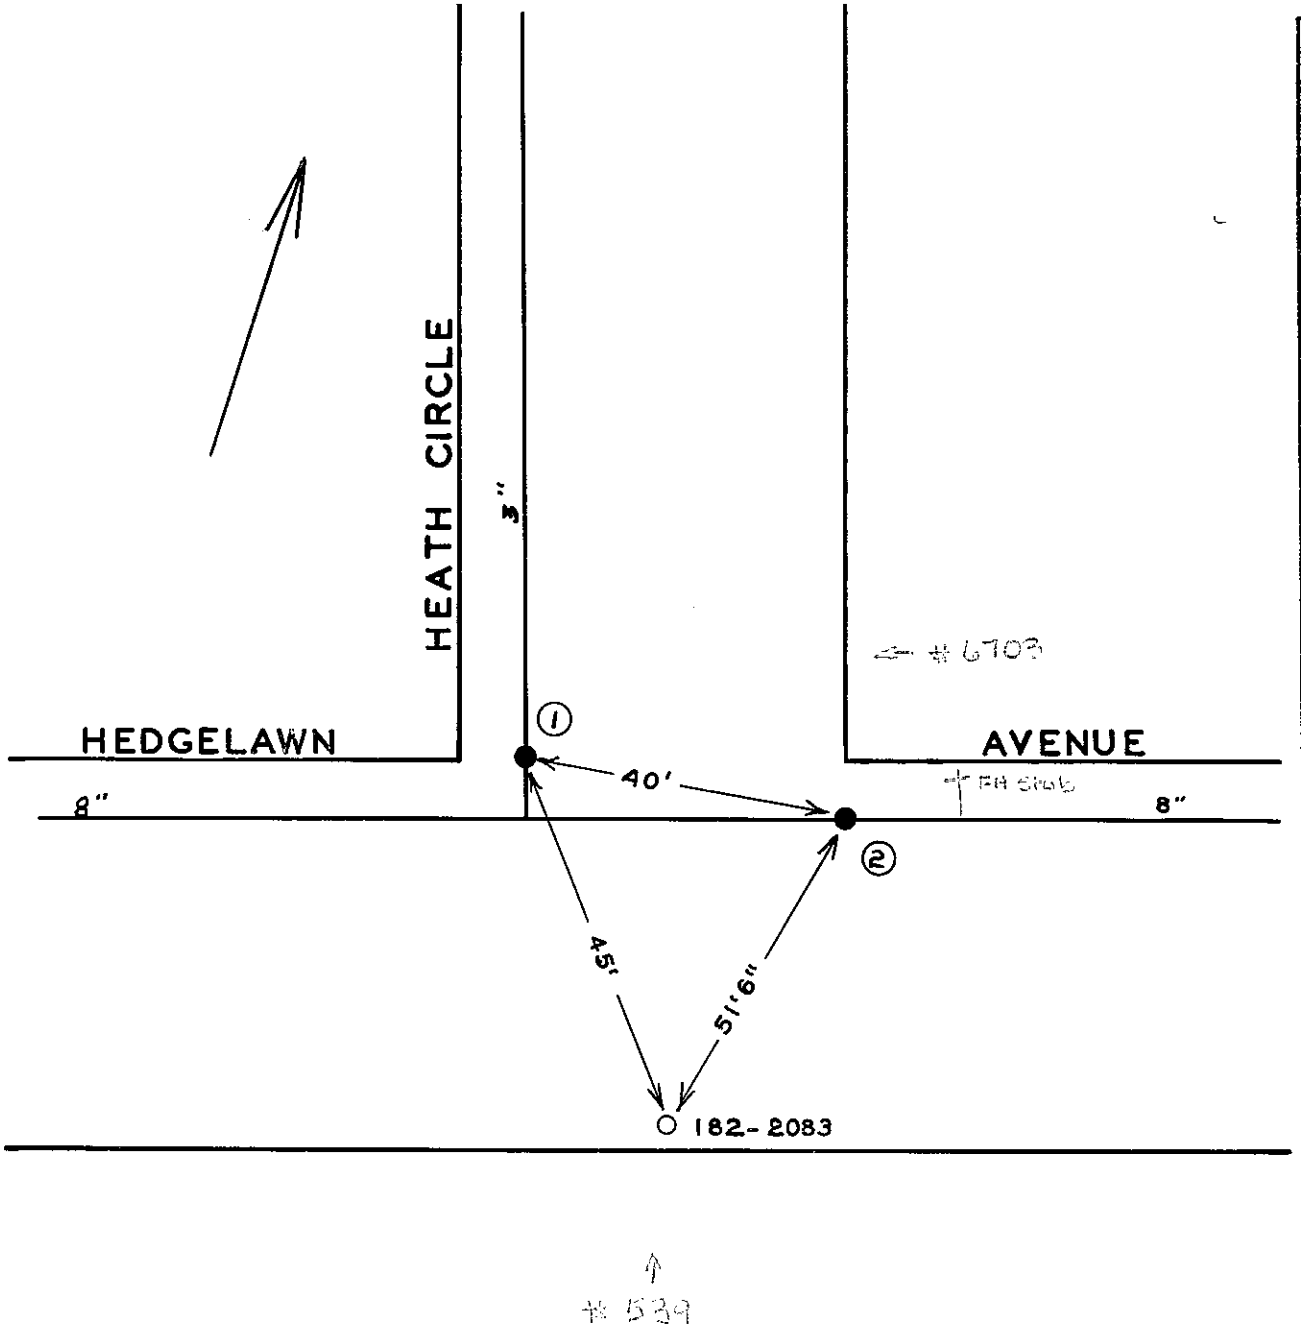

DATE	NO.	SIZE	MAKE	OPEN	TURNS
12-63	1	3"	MUELLER	R	12
12-63	2	8"	MUELLER	R	27
	1	0	N.P.L.		
	2	0	E.P.L.		

CITY OF ROANOKE—WATER DEPT.

VALVE DIAGRAM

HEATH CIRCLE &

HEDGELAWN AVENUE N.E.

SEC. MAP 46 Roanoke County

DATE **PAGE NO.**