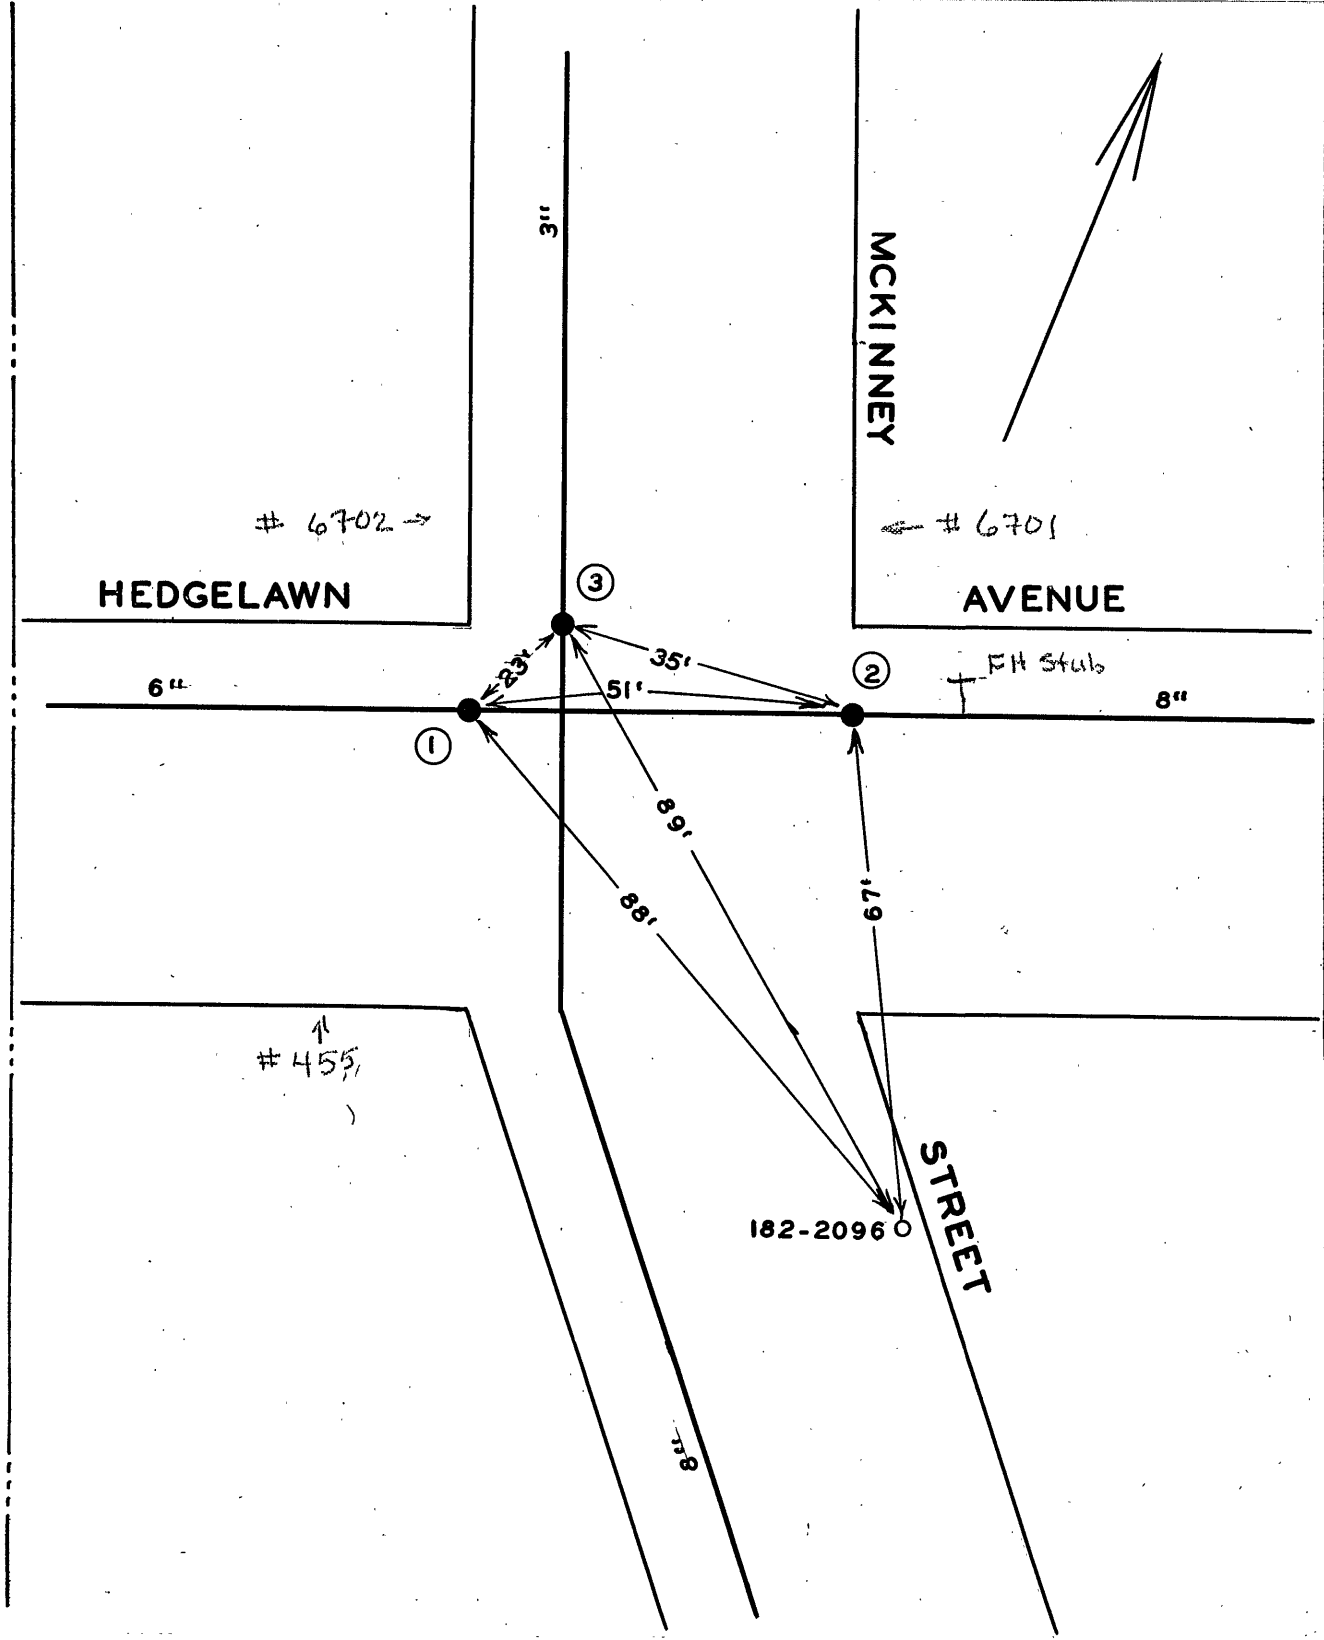

DATE	NO.	SIZE	MAKE	OPEN	TURNS
12-63	1	6"	MUELLER	R	21
12-63	2	8"	MUELLER	R	27
12-63	3	3"	MUELLER	R	12
	1	0	W.P.L.		
	2	0	E.P.L.		
	3	0	N.P.L.		

CITY OF ROANOKE—WATER DEPT.

VALVE DIAGRAM

HEDGELAWN AVENUE &

McKINNEY STREET N.E.

SEC. MAP 46 Roanoke County

DATE PAGE NO.