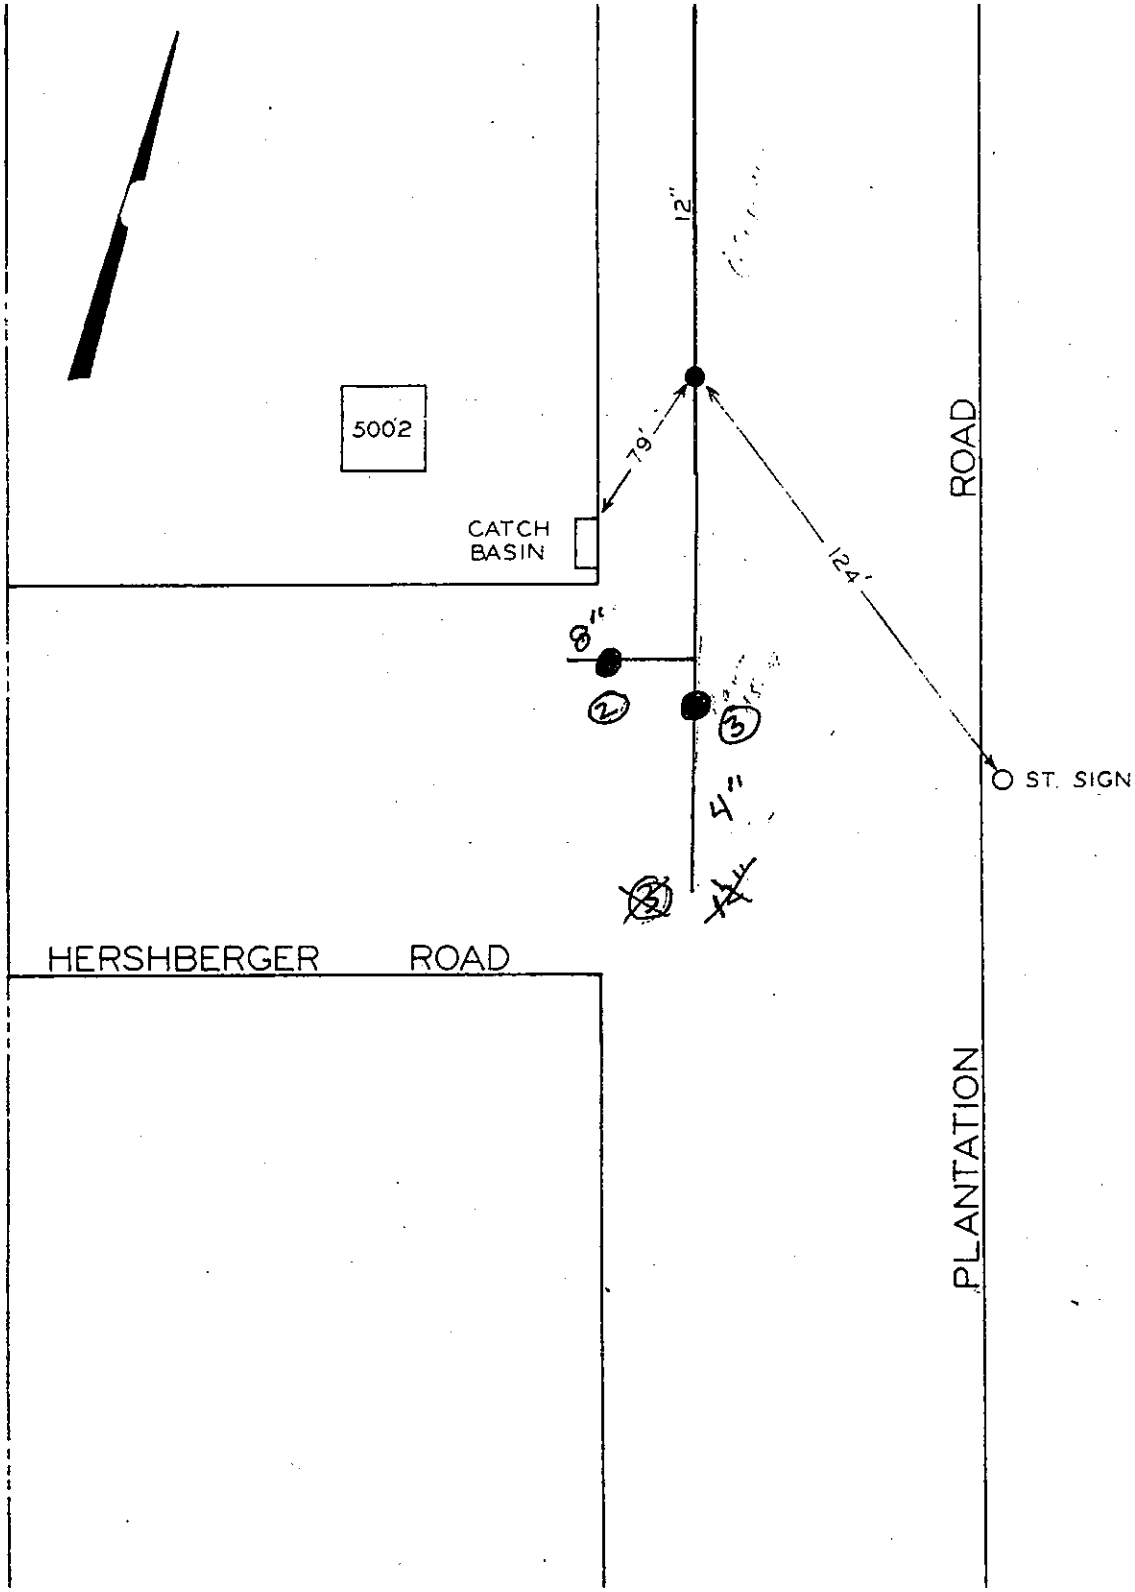

DATE	NO.	SIZE	MAKE	OPEN	TURNS
71	1	12"	MUELLER	R	
1985	2	8"			
1985	3	12"			

CITY OF ROANOKE—WATER DEP'T

VALVE DIAGRAM

HERSHBERGER ROAD &
PLANTATION ROAD N.E.

SEC. MAP 69 Roanoke County

DATE JUL 9 197 PAGE NO