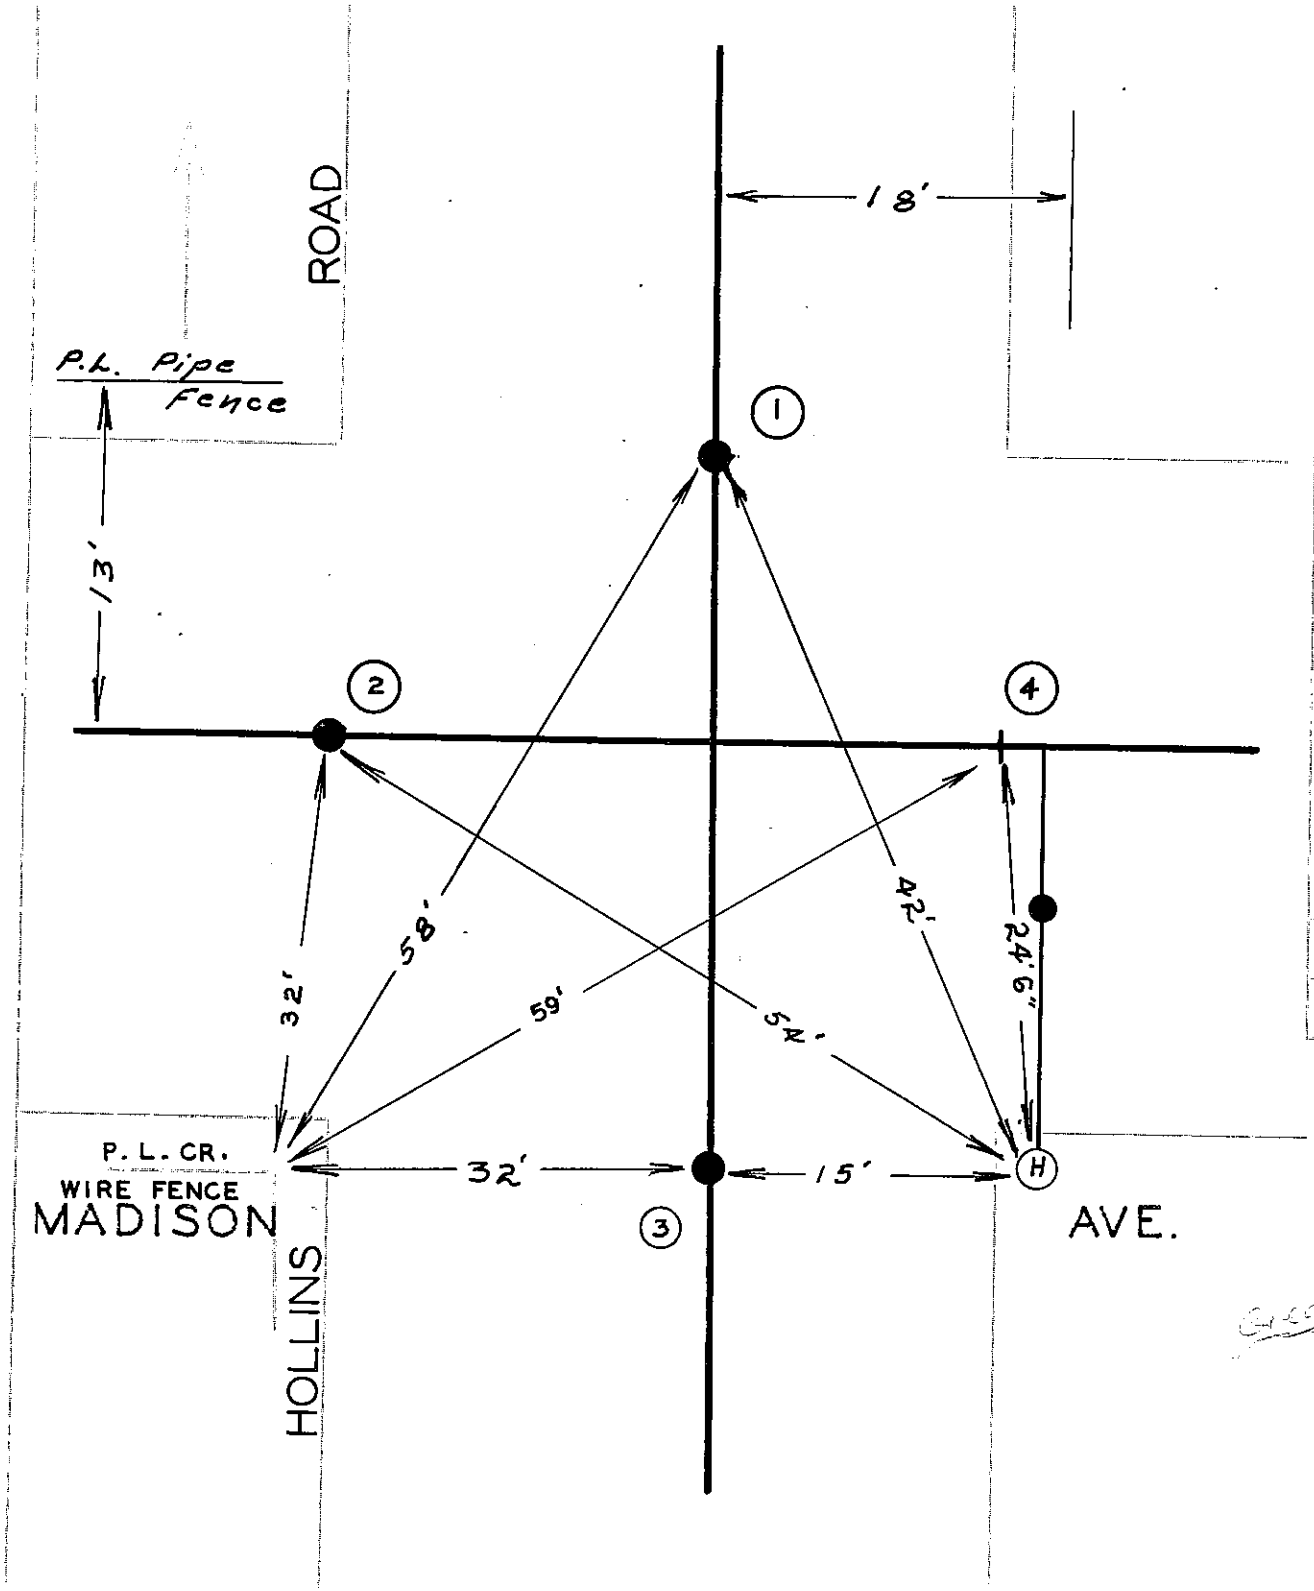

DATE	No.	SIZE	NAME	CONT.	TURNS
1952	1	8"	MUELLER	R	26
1917	2	6"		R	20
1952	3	8"			
1926	4	6"		R	21
	1	0	NPL		
	2	5'W	EPL		
	3	0	SPL		
	4	0	EPL		

VALVE DIAGRAM
(Gregory)
HOLLINS ROAD &
MADISON AVENUE N.E.

SHEET NO. 303
DATE
FILE NO. NE 59