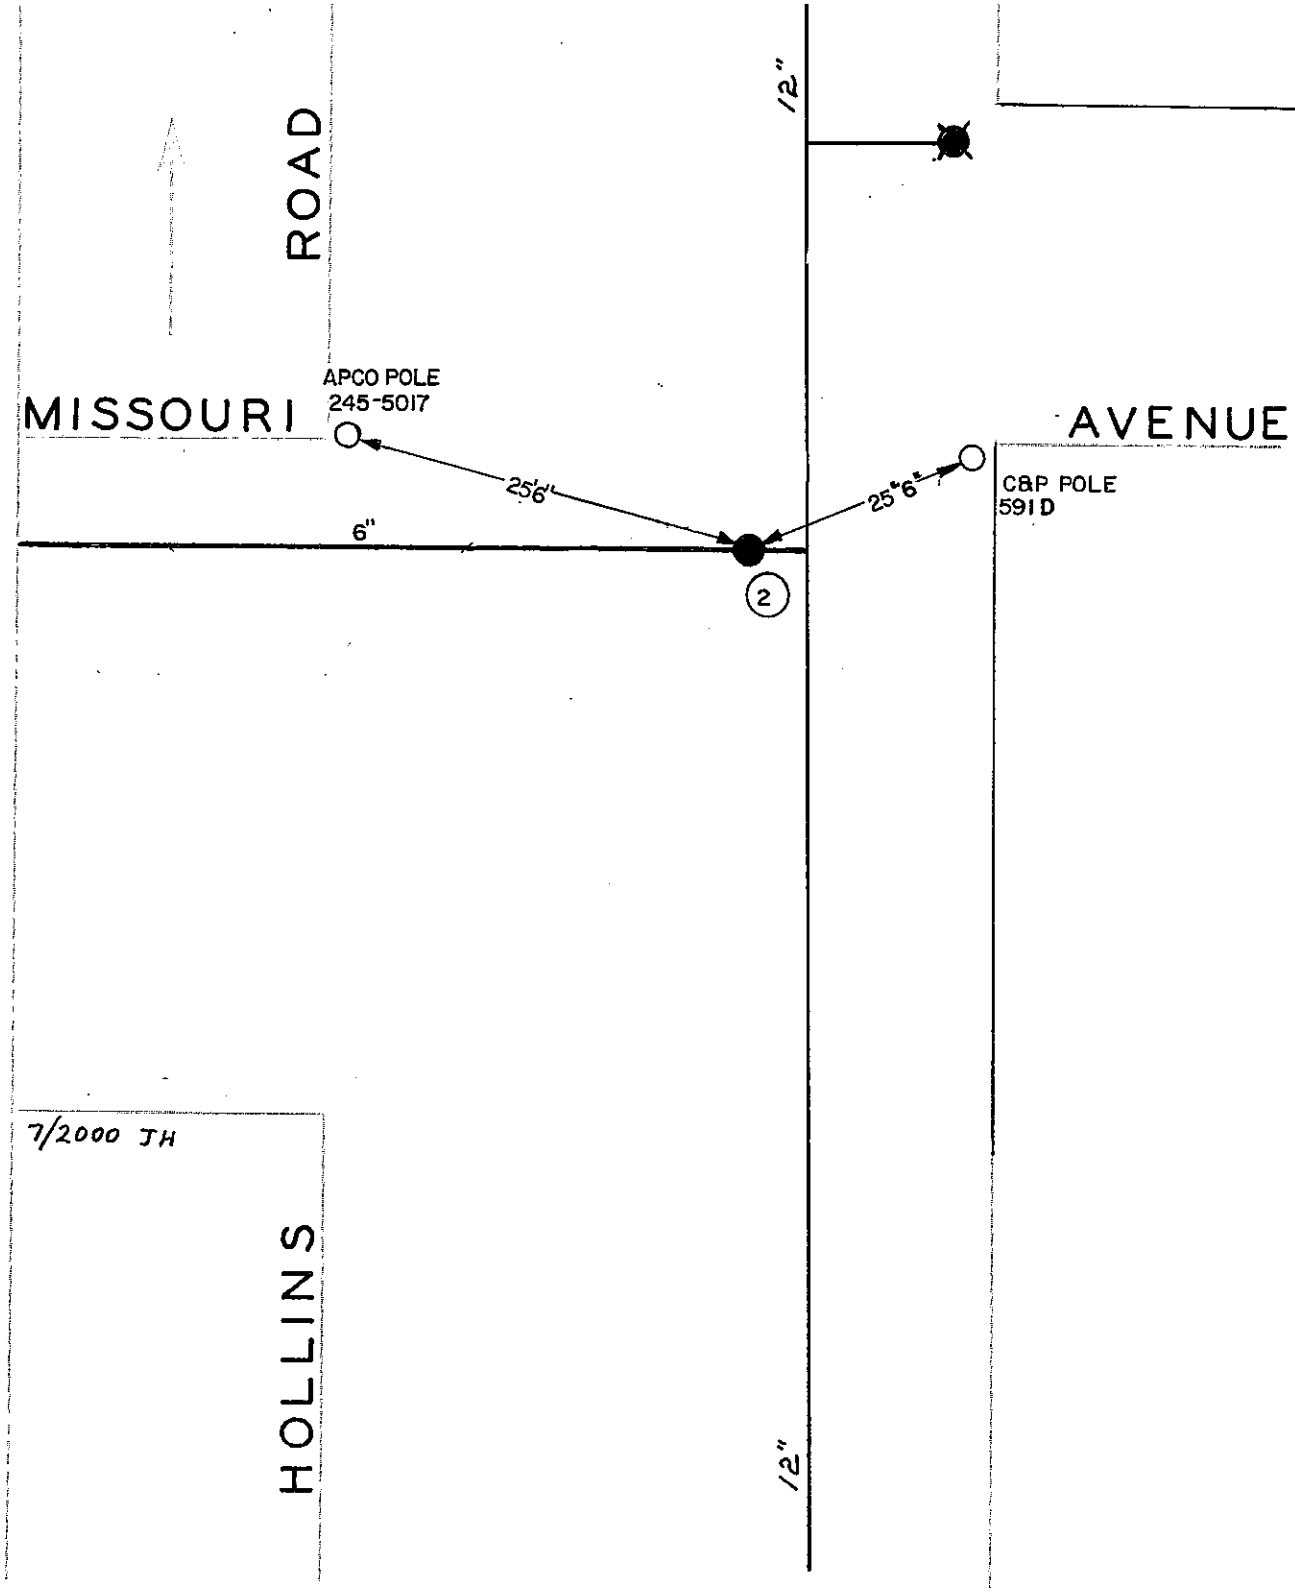

TYPE	SIZE	DIST	MAKE	POS	PHOTO
9-80	2	6"	MUELLER	R	
	1	0	W P L		
	2	19'6"	E.P.L.		

CITY OF ROANOKE—WATER DEPT
VALVE DIAGRAM

HOLLINS ROAD &
MISSOURI AVE. N.E.

LEG DIST 311

DAT. TYPE BY