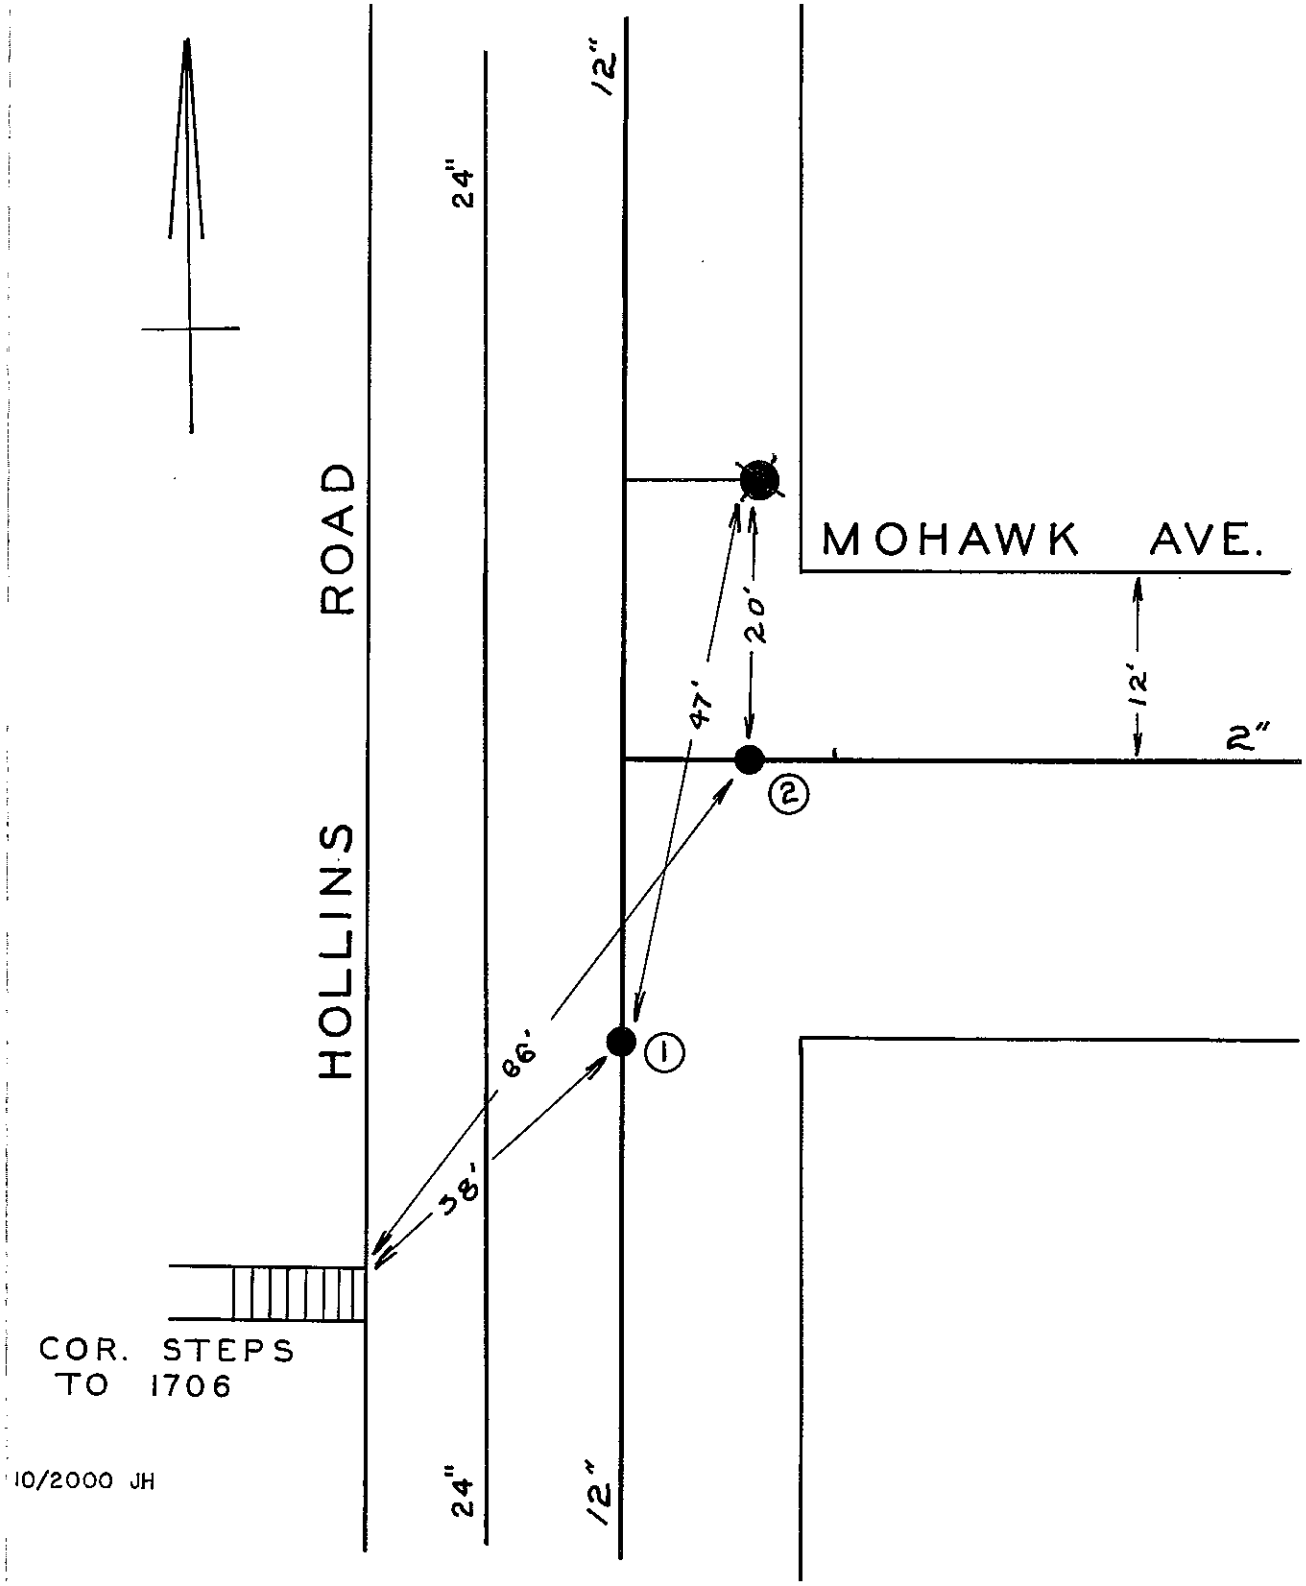

DATE	TOP	SIZE	MAKE	OPEN	TURNS
1953	1	12"		R	
1926	2	2"		R	
	1	0	SPL		
	2	5'-W	EPL		

CITY OF ROANOKE – WATER DEPT.

VALVE DIAGRAM

HOLLINS RD. &

MOHAWK AVE.

REG. MAP 306 N.E.

DATE PAGE NO.