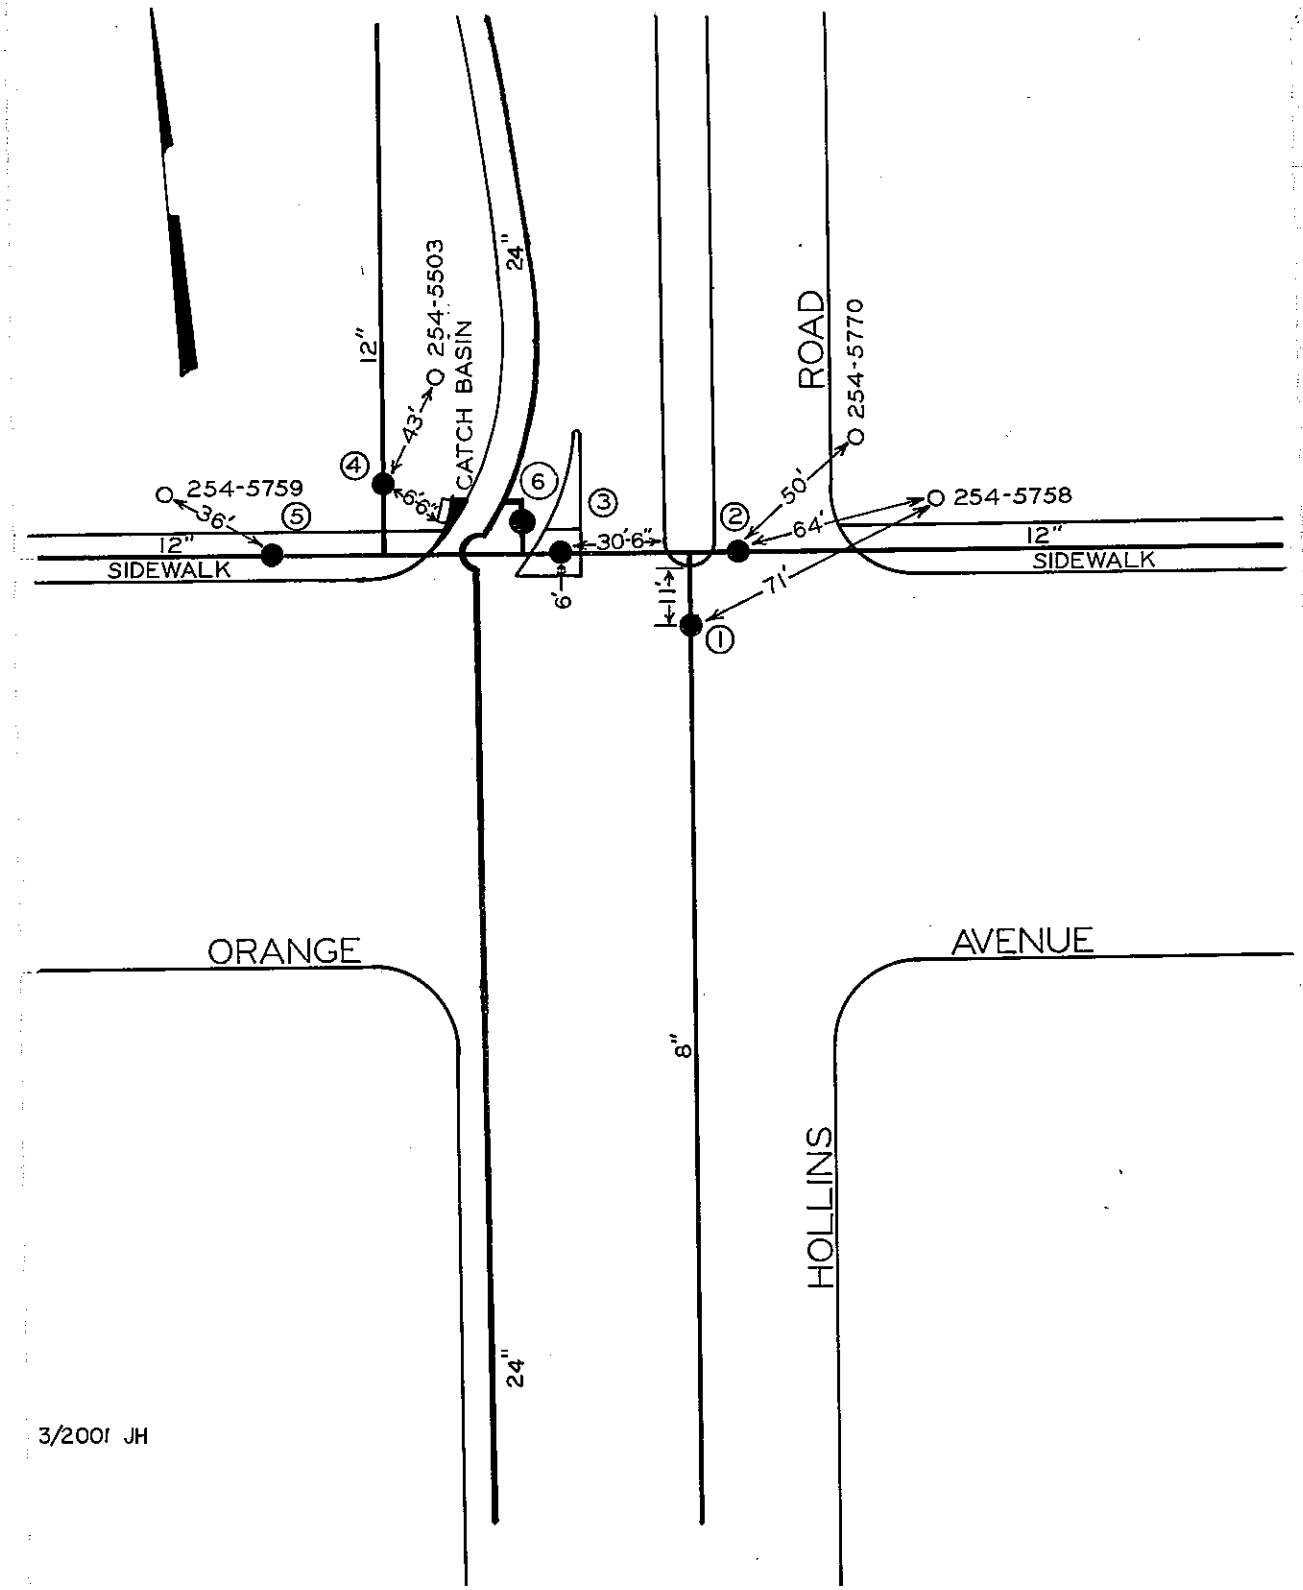

72	1	8"	MUELLER	R	27
72	2	12"	MUELLER	R	38
72	3	12"	MUELLER	R	38
72	4	12"	MUELLER	R	38
72	5	12"	MUELLER	R	38
1995	6	?			

HOLLINS ROAD &
ORANGE AVENUE

304 , 305 N.E.