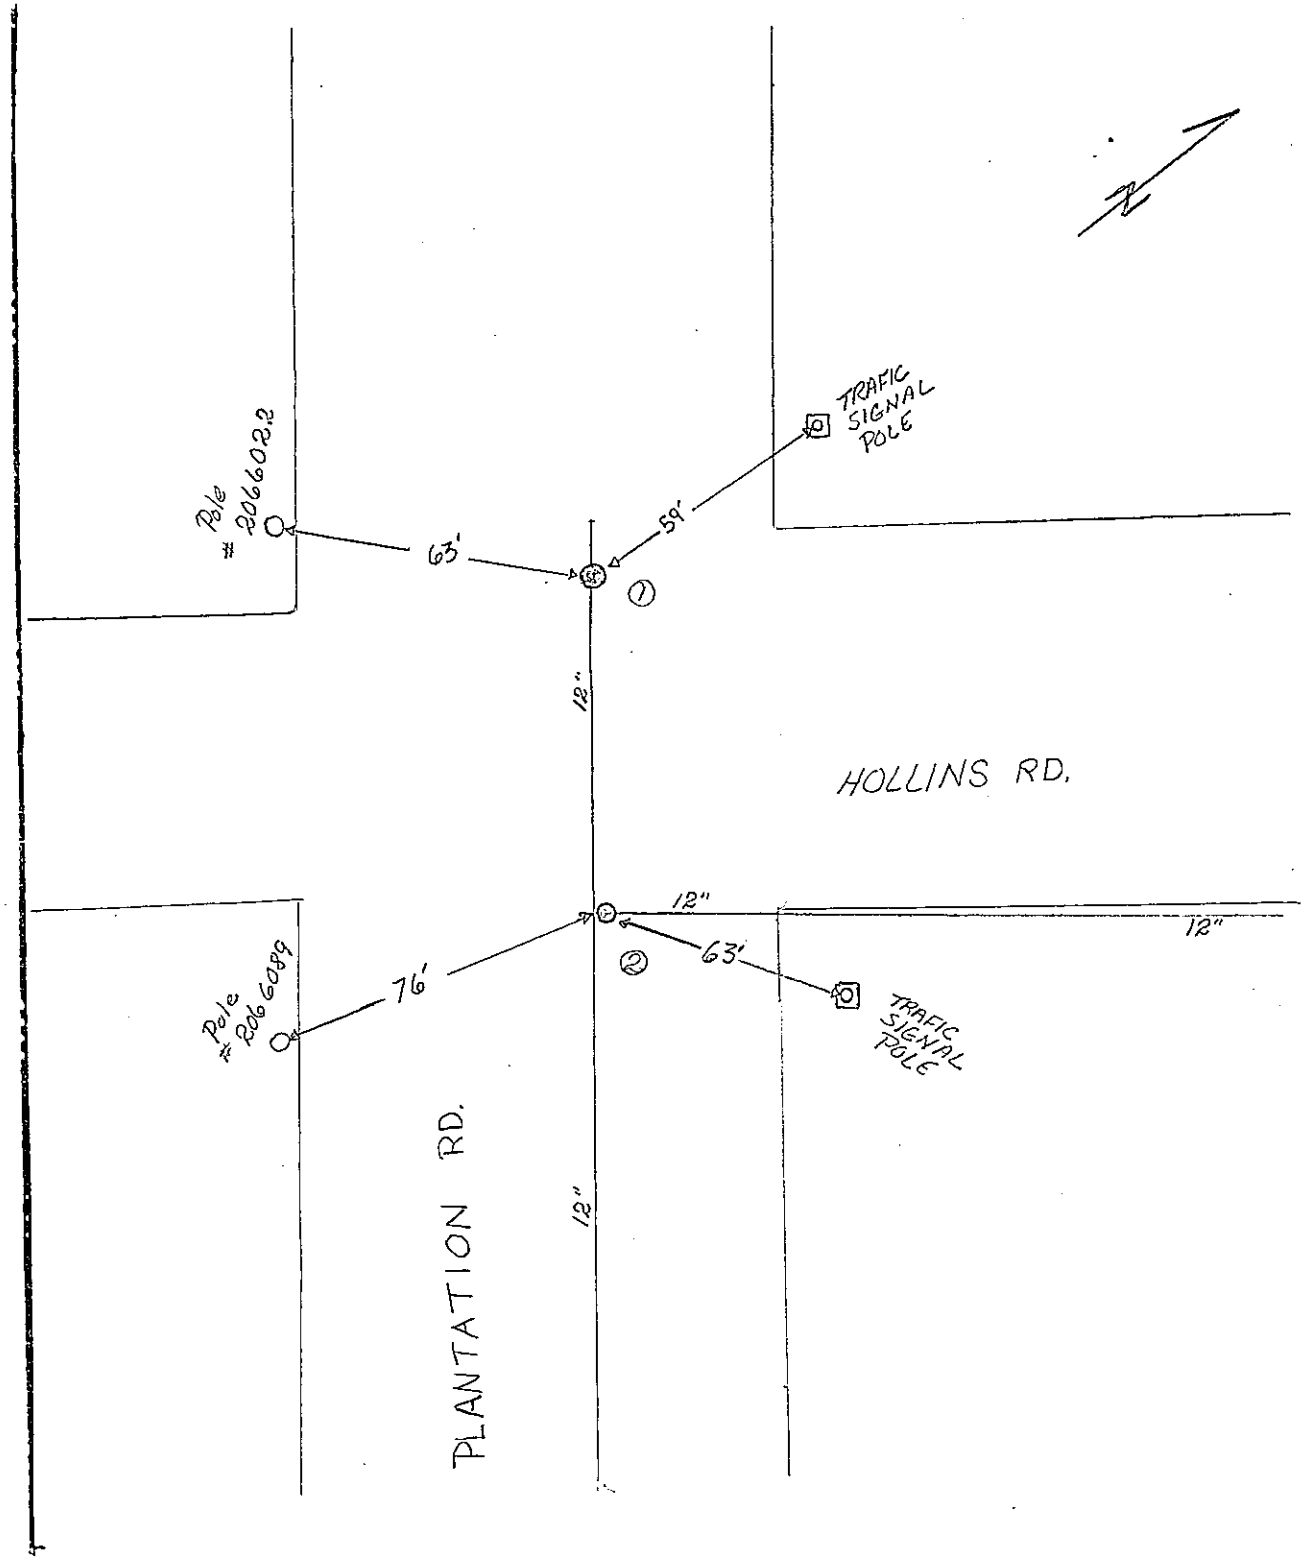

DATE	NO.	SIZE	MAKE	OPEN	TURNS
	1	12"		R	39
10-95	2	12"	DARL.	R	39

CITY OF ROANOKE—WATER DEPT
VALVE DIAGRAM

HOLLINS RD. and PLANTATION RD. N.E.

SEC. MAP

DATE PAGE NO.