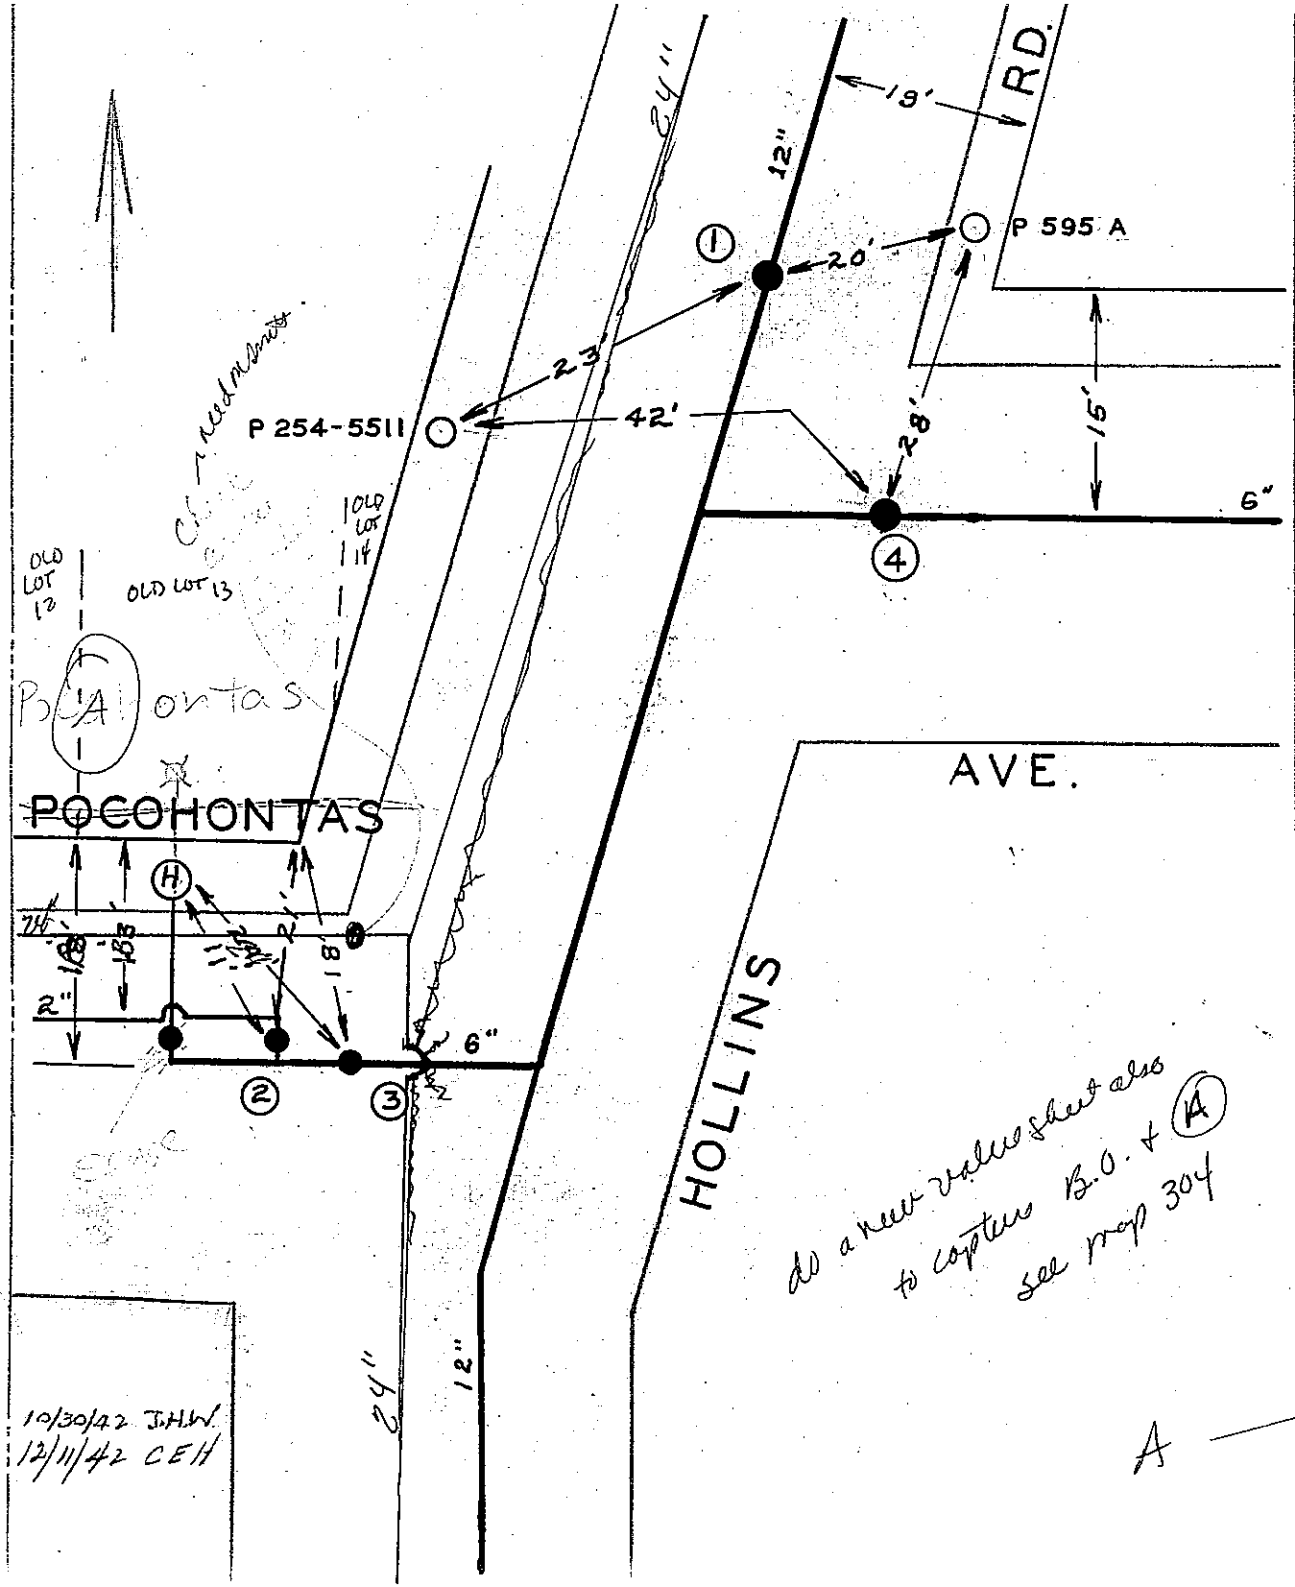

DATE	NO.	SIZE	MAKE	OPEN	TURNS
53	1	12"		R	
53	2	2"		R	
53	3	6"		R	
53	4	6"		R	
	1	0	NPL		
	2	13'-W	WPL		
	3	2'-E	WPL		
	4	0	EPL		

CITY OF ROANOKE—WATER DEP'T
VALVE DIAGRAM

HOLLINS RD. &
POCOHONTAS AVE. N.E.

SEC. MAP 304

DATE PAGE NO. NE 70

A