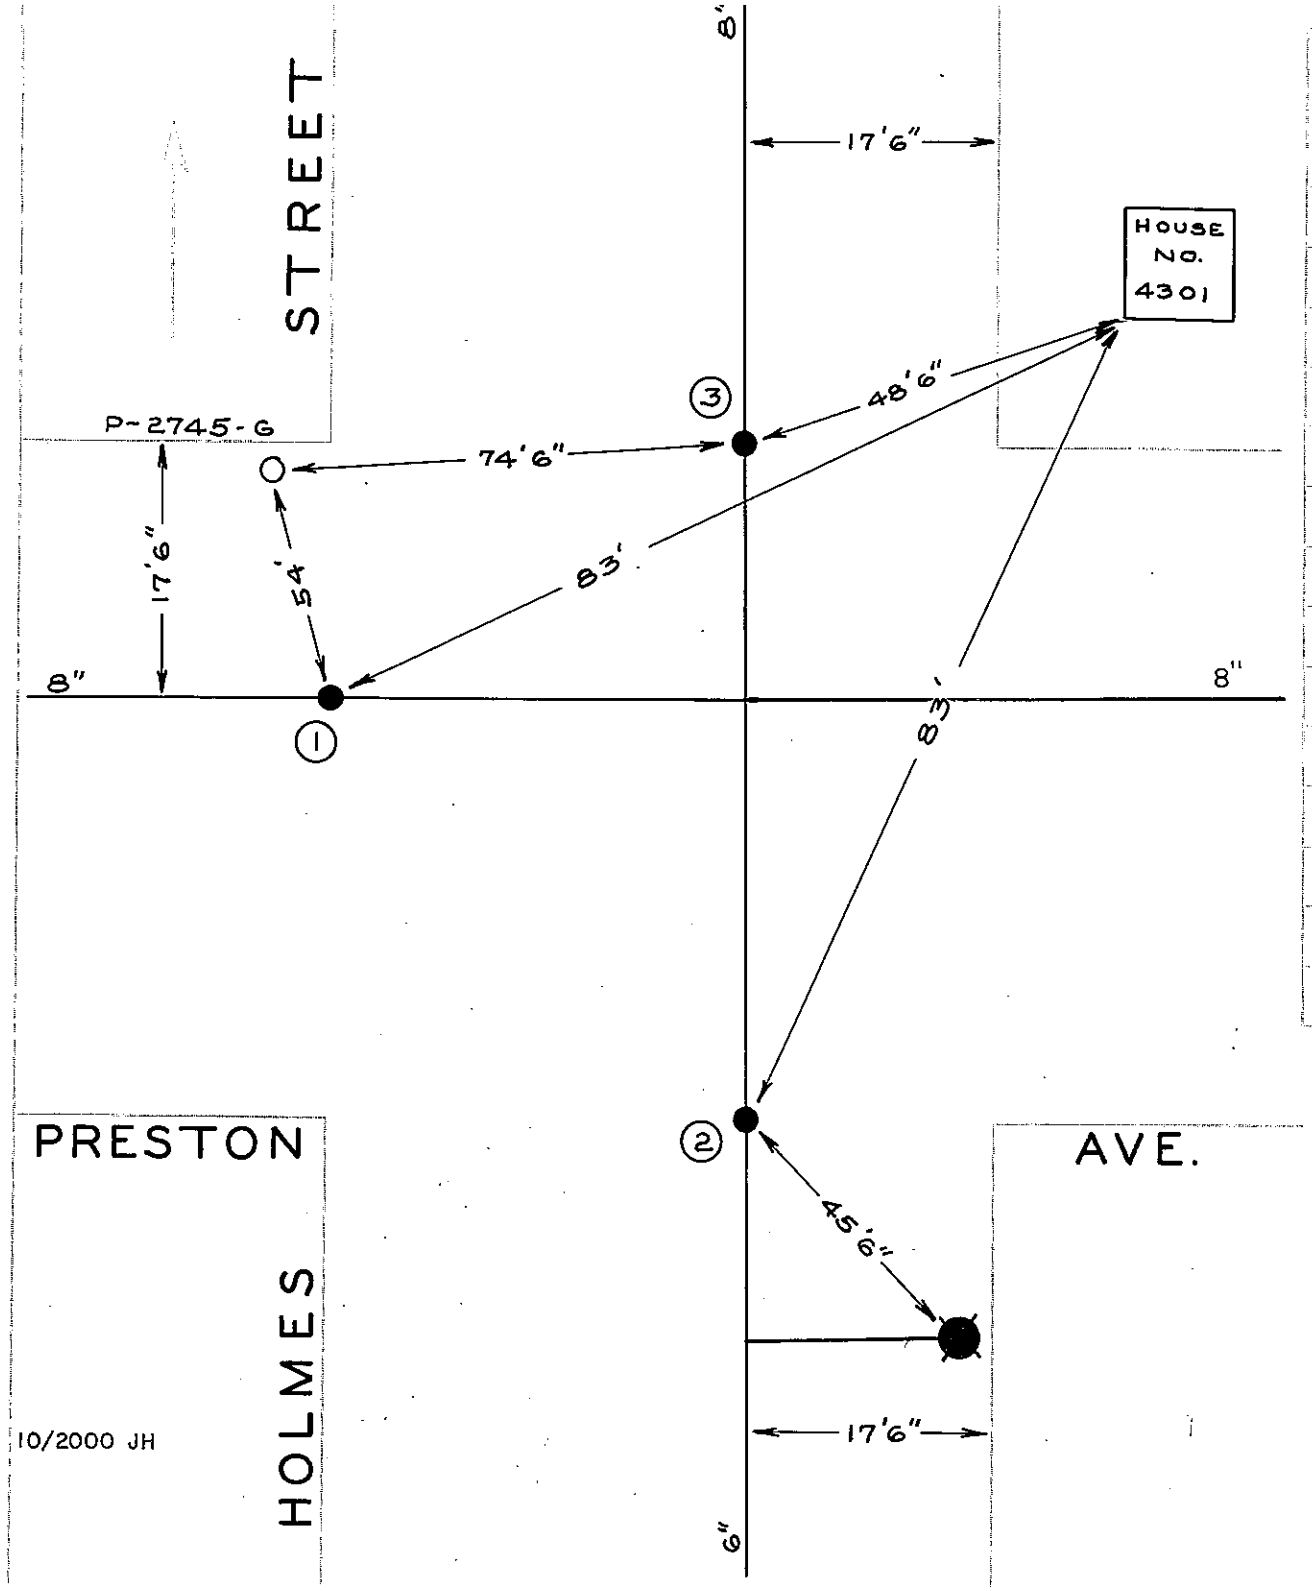

DATE	NO	SIZE	NAME	OPEN	SHUT
1956	1	8"	MUE.	R	
1956	2	6"	MUE.	R	
1957	3	8"	DAR.	R	
	1	0	WPL		
	2	0	SPL		
	3	0	NPL		

CITY OF ROANOKE—WATER DEPT
VALVE DIAGRAM

HOLMES ST. &
PRESTON AVE.

CITY MAP 319 N.E.

DATE PAGE

10/2000 JH