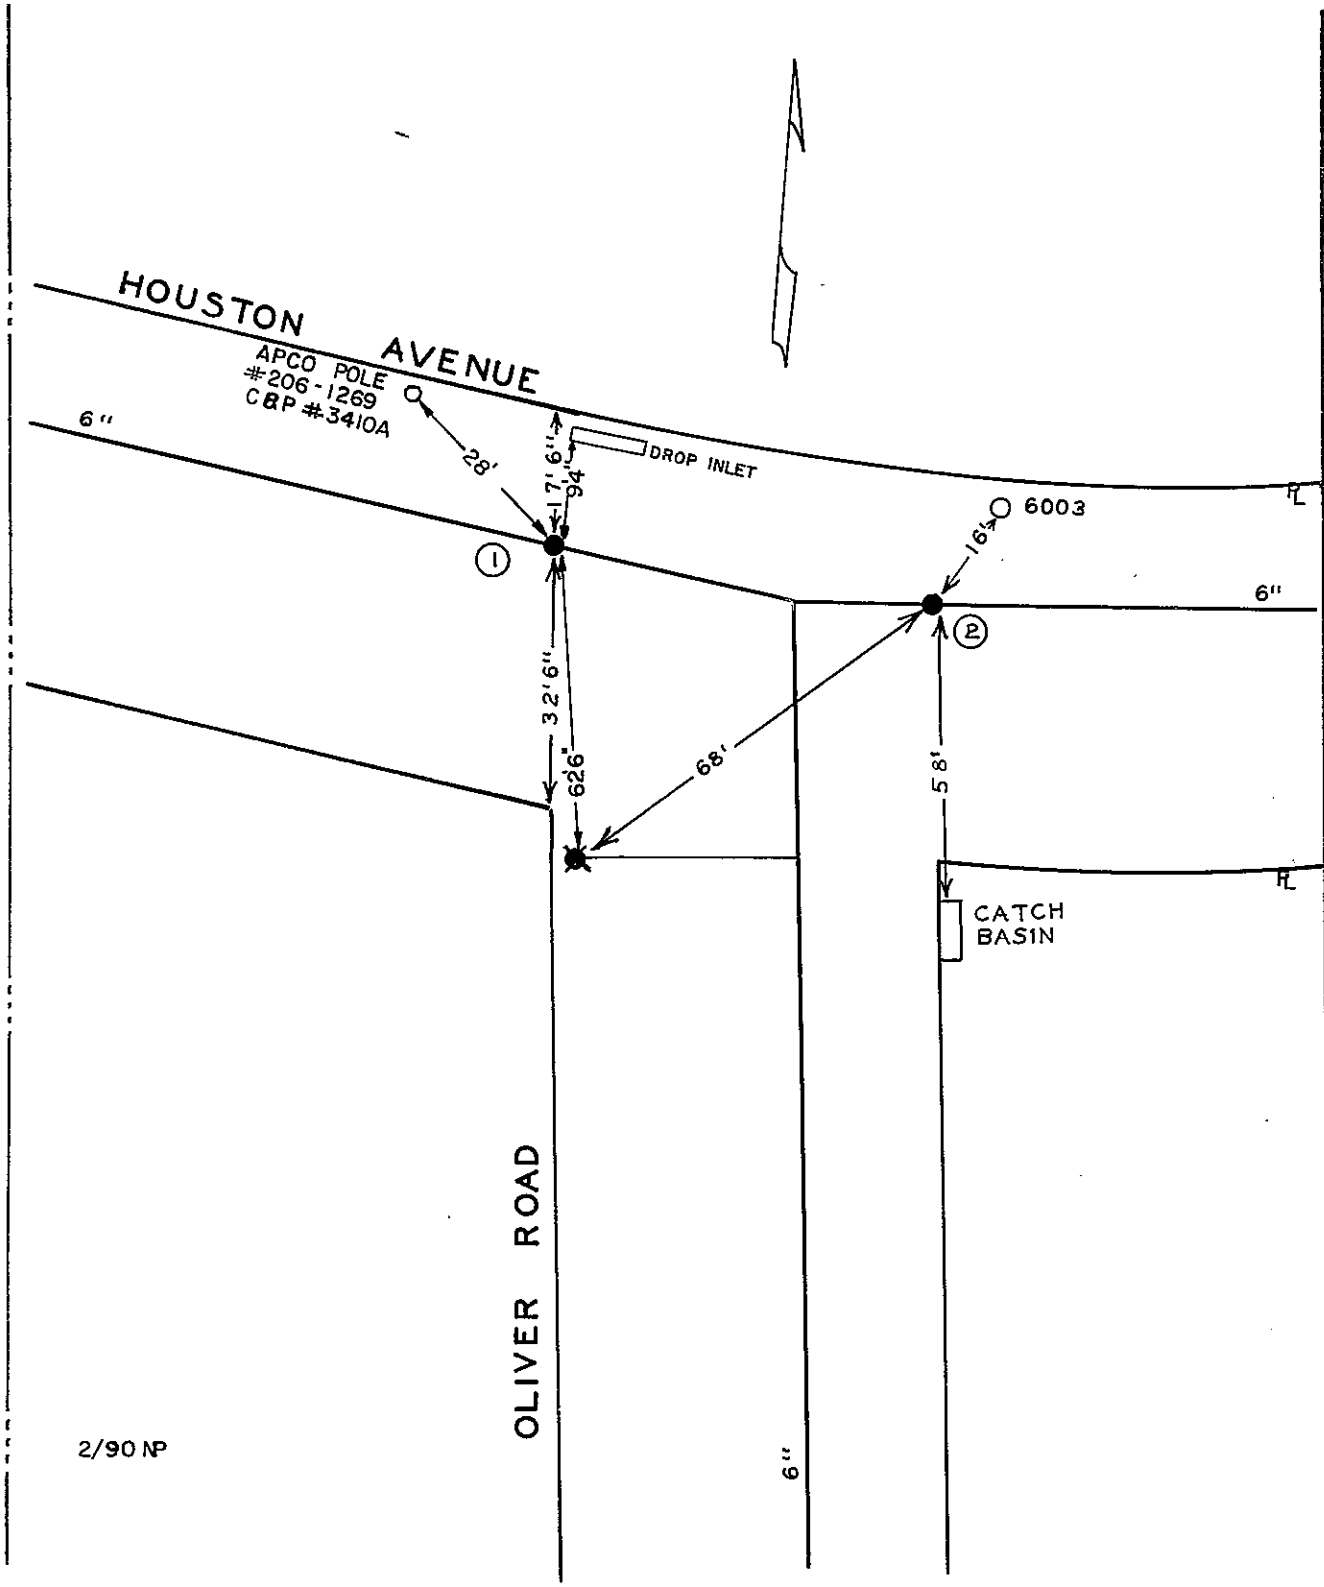

DATE	NO.	SIZE	MAKE	OPEN	TURNS
10-61	1	6"	MUELLER	R	20
9-66	2	6"	MUELLER	R	

CITY OF ROANOKE—WATER DEPT.

VALVE DIAGRAM

HOUSTON AVENUE &

OLIVER ROAD N.E.

SEC. MAP 320

DATE **PAGE NO.**