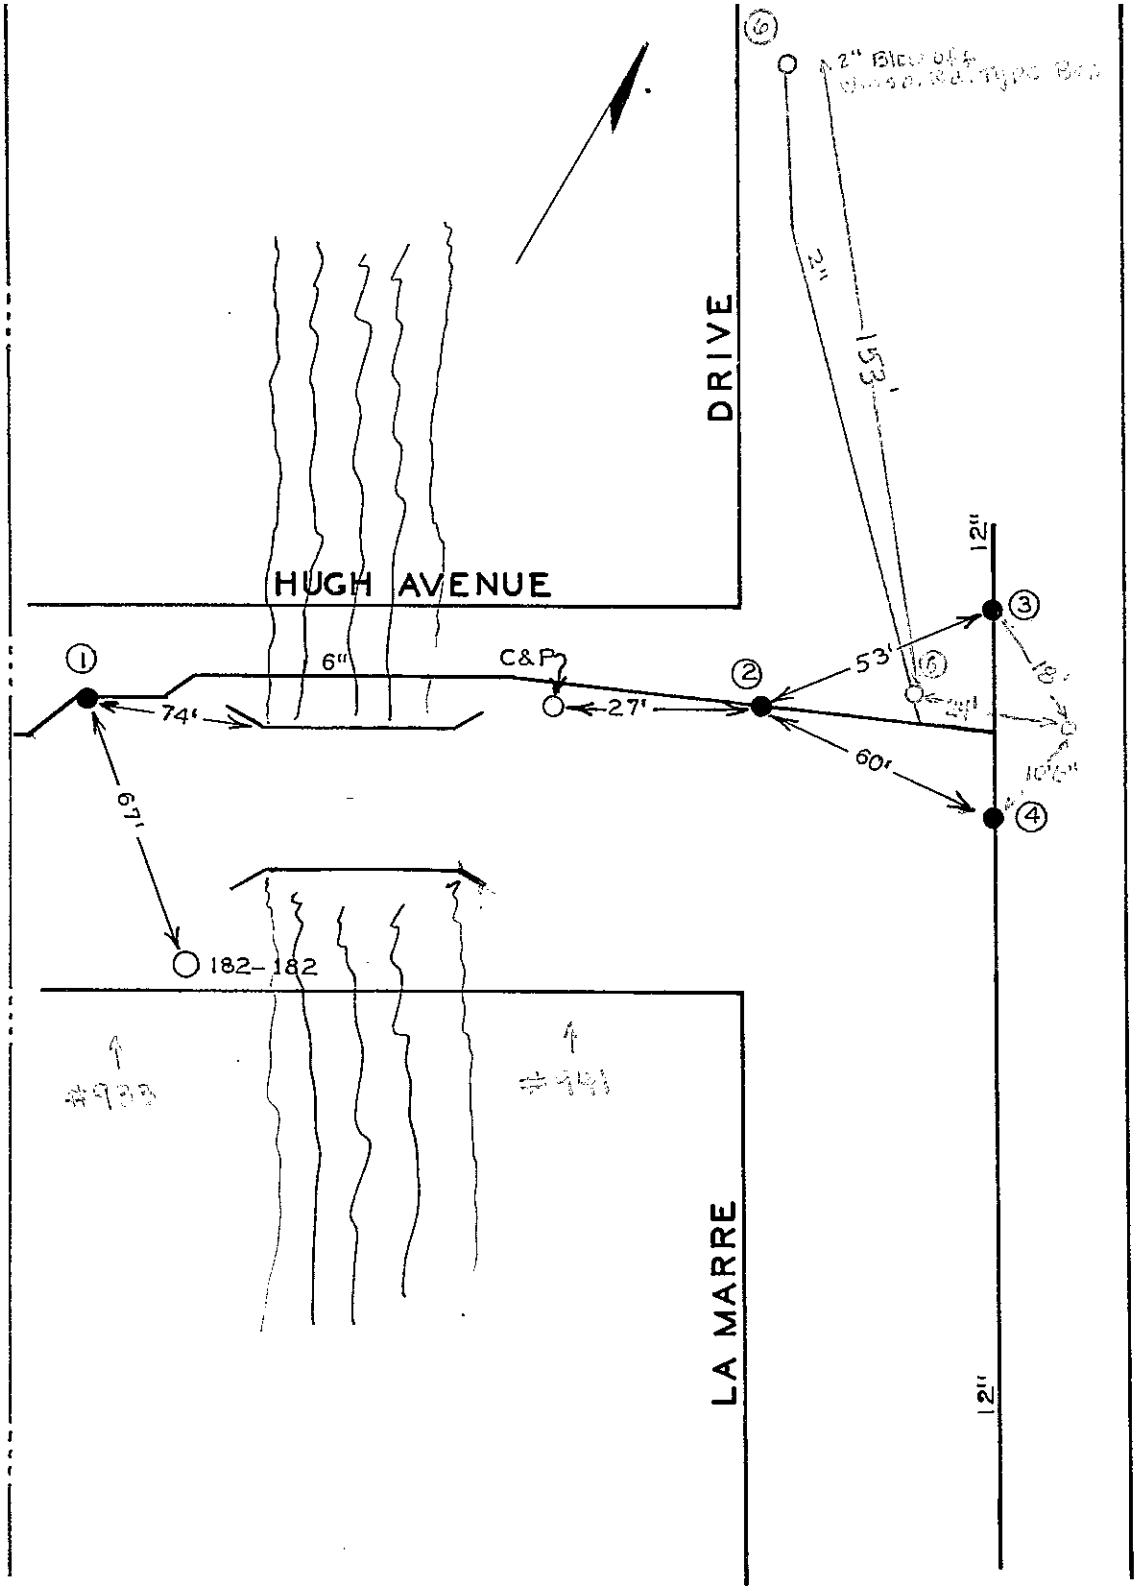

DATE	NO.	SIZE	MAKE	OPEN	TURNS
66SD	1	6"	MUELLER	R	
66SD	2	6"	MUELLER	R	
66SD	3	12	MUELLER	R	
66SD	4	12	MUELLER	R	
1-69	5	2"	DARLING	R	
1-69	6	2"	Misc. Blow Off		

CITY OF ROANOKE—WATER DEPT.

VALVE DIAGRAM

HUGH AVENUE &

LAMARRE DRIVE N.E.

SEC. MAP 58 Roanoke County

DATE **PAGE NO.**