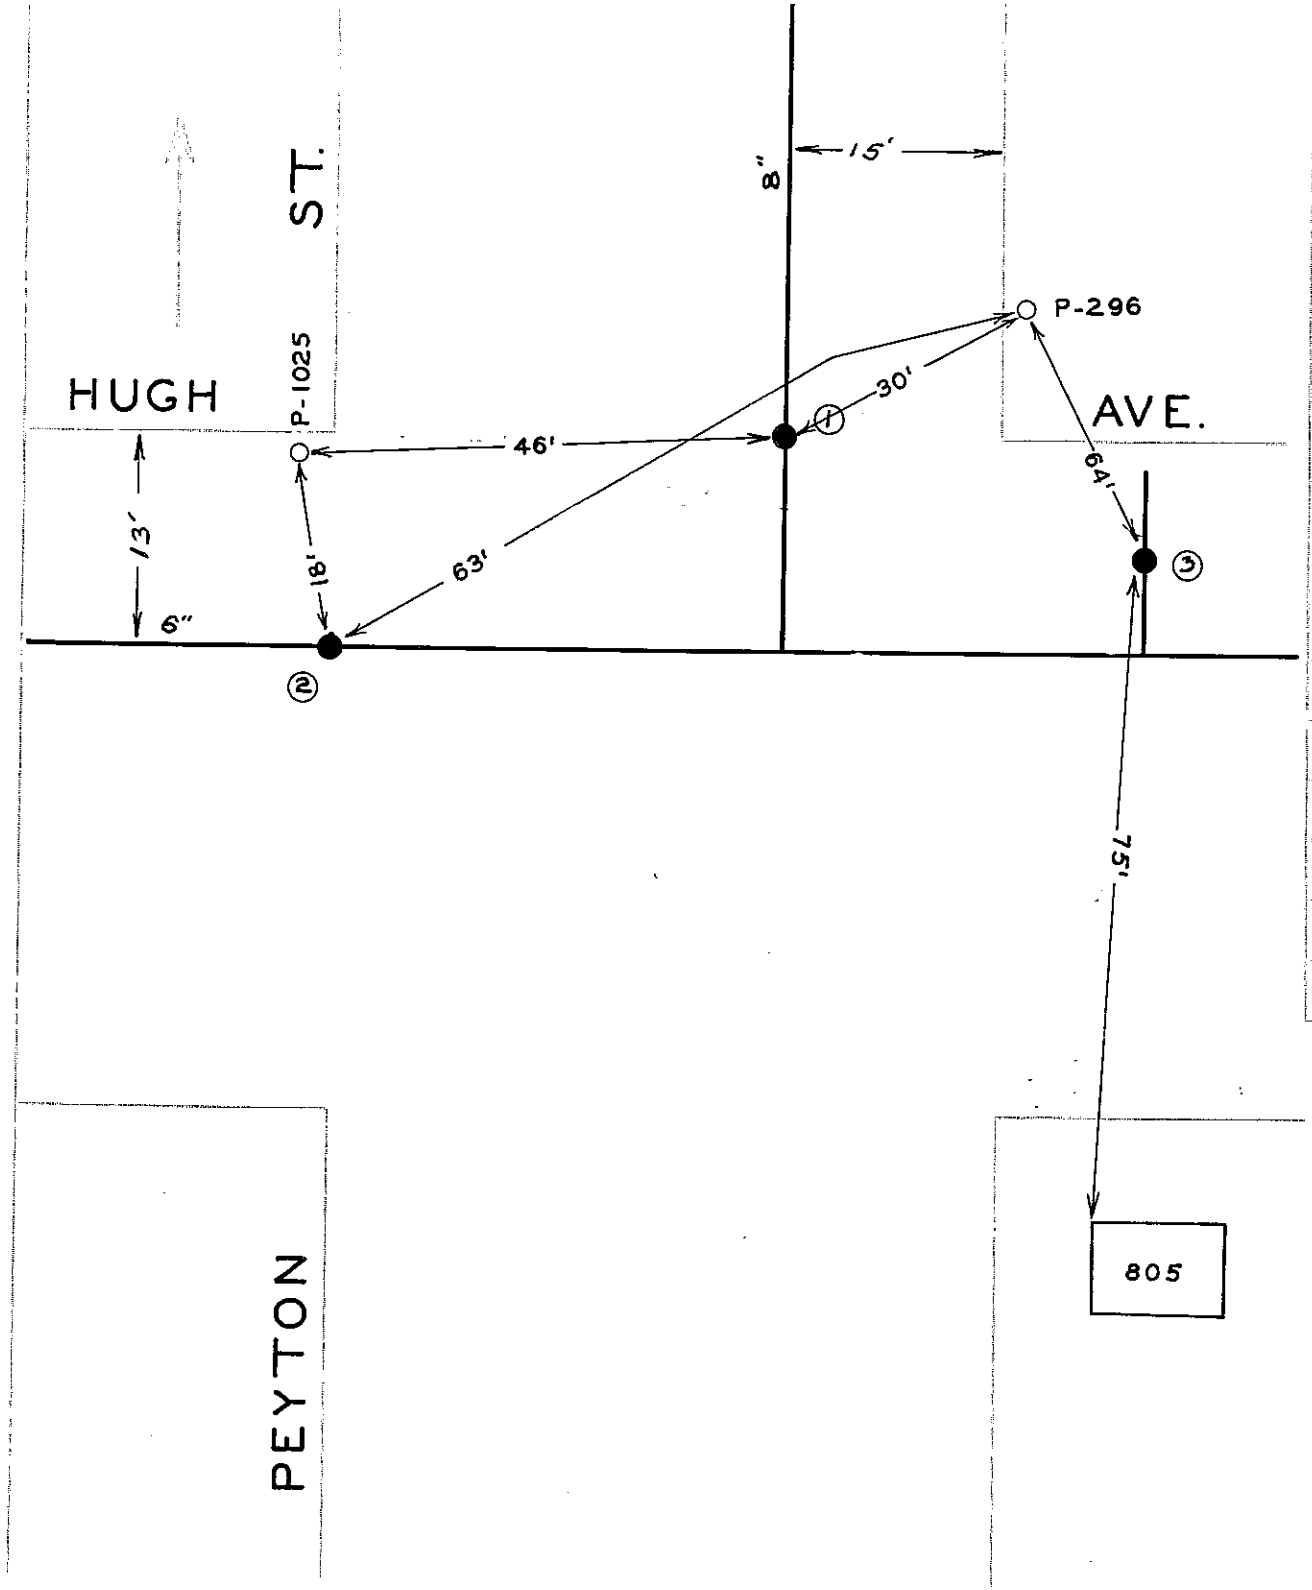

DATE	NO	SIZE			
	1	8"			
	2	6"			
	3	6"	H-Stub		
	1	0	NPL		
	2	0	WPL		

CITY OF ROANOKE—WATER DEPT
VALVE DIAGRAM

HUGH AVE. & PEYTON ST.

N.E. S. END.

SEC. 18 Roanoke County

DATE PAGE NO.