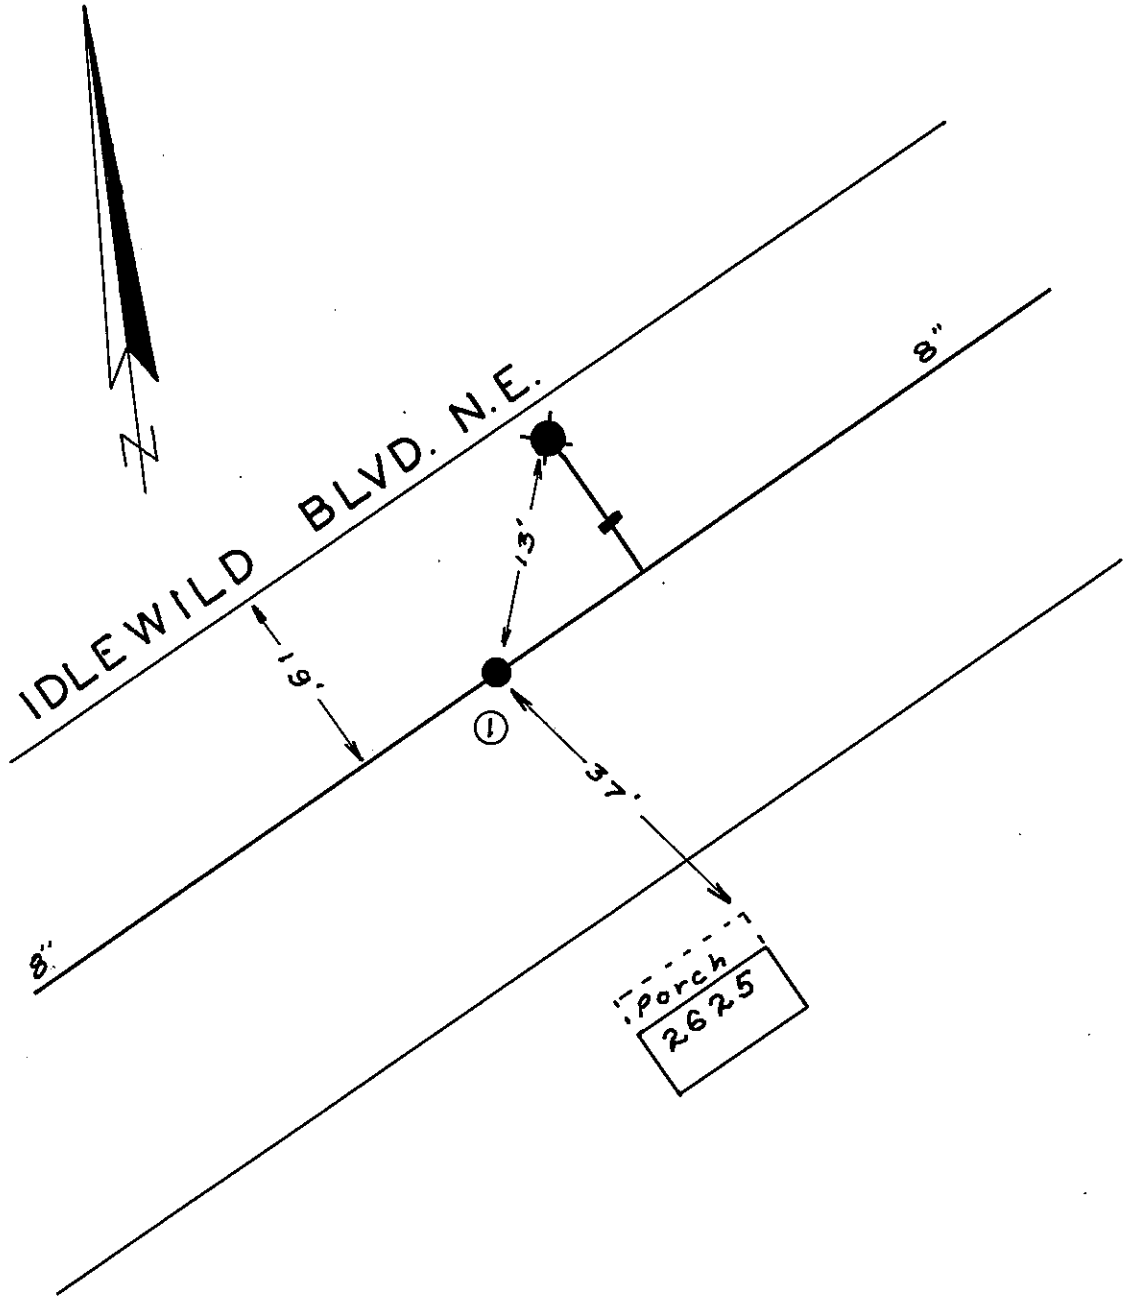

DATE	NO.	SIZE	PLAN	OPR	CUT IN
1952	1	8"	MUELLER	R	
	1	885'-E	EPL		

IDLEWILD BLVD. AT
2625

341 N.E.

11/2000 JH