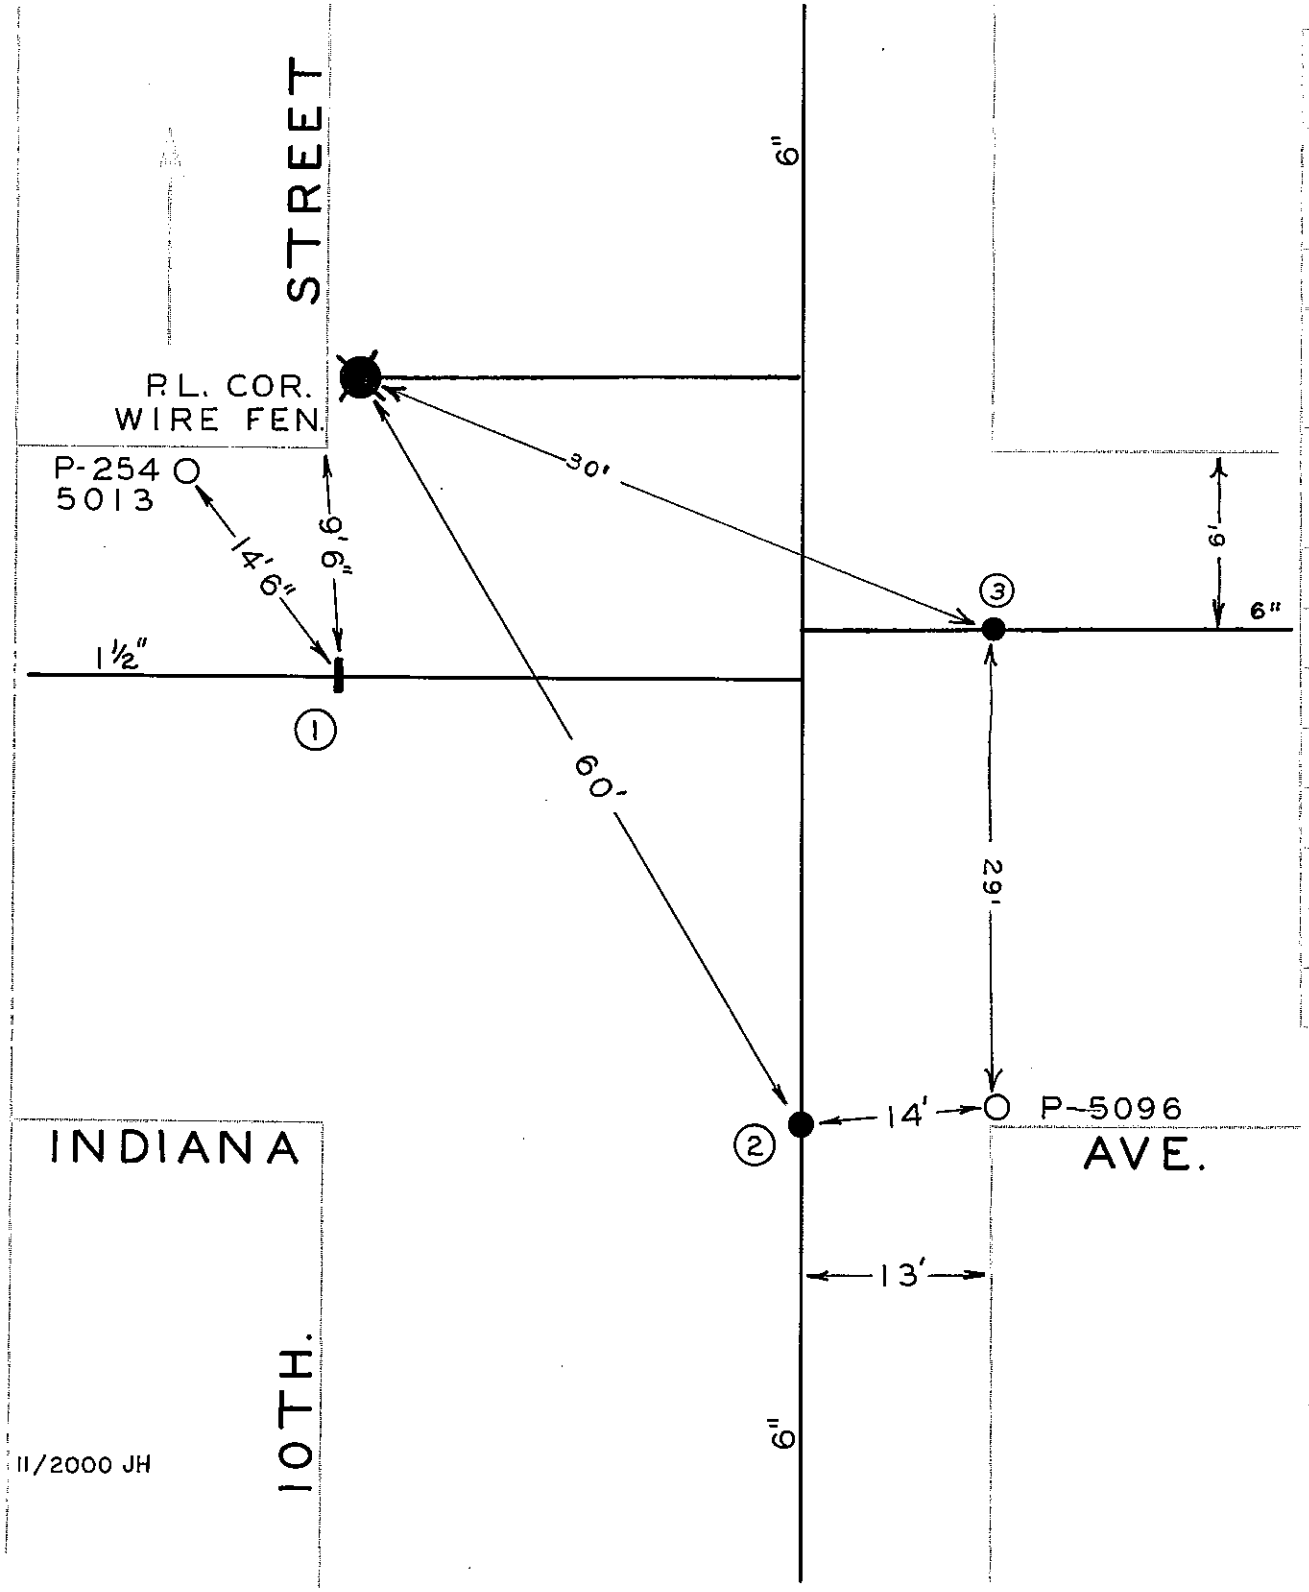

YEAR	NO.	VALVE	MAKE	OPEN	TURNS
'25	1	2"		L	8
'53	2	6"			
10-67	3	6"	DARLING	R	
	1	2'-E	W P L		
	2	0	S P L		
	3	7' W	E.P.L.		

CITY OF ROANOKE—WATER DEPT
VALVE DIAGRAM

INDIANA AVE. &
10TH. ST.

MAP 306 N.E.

DATE PAGE NO