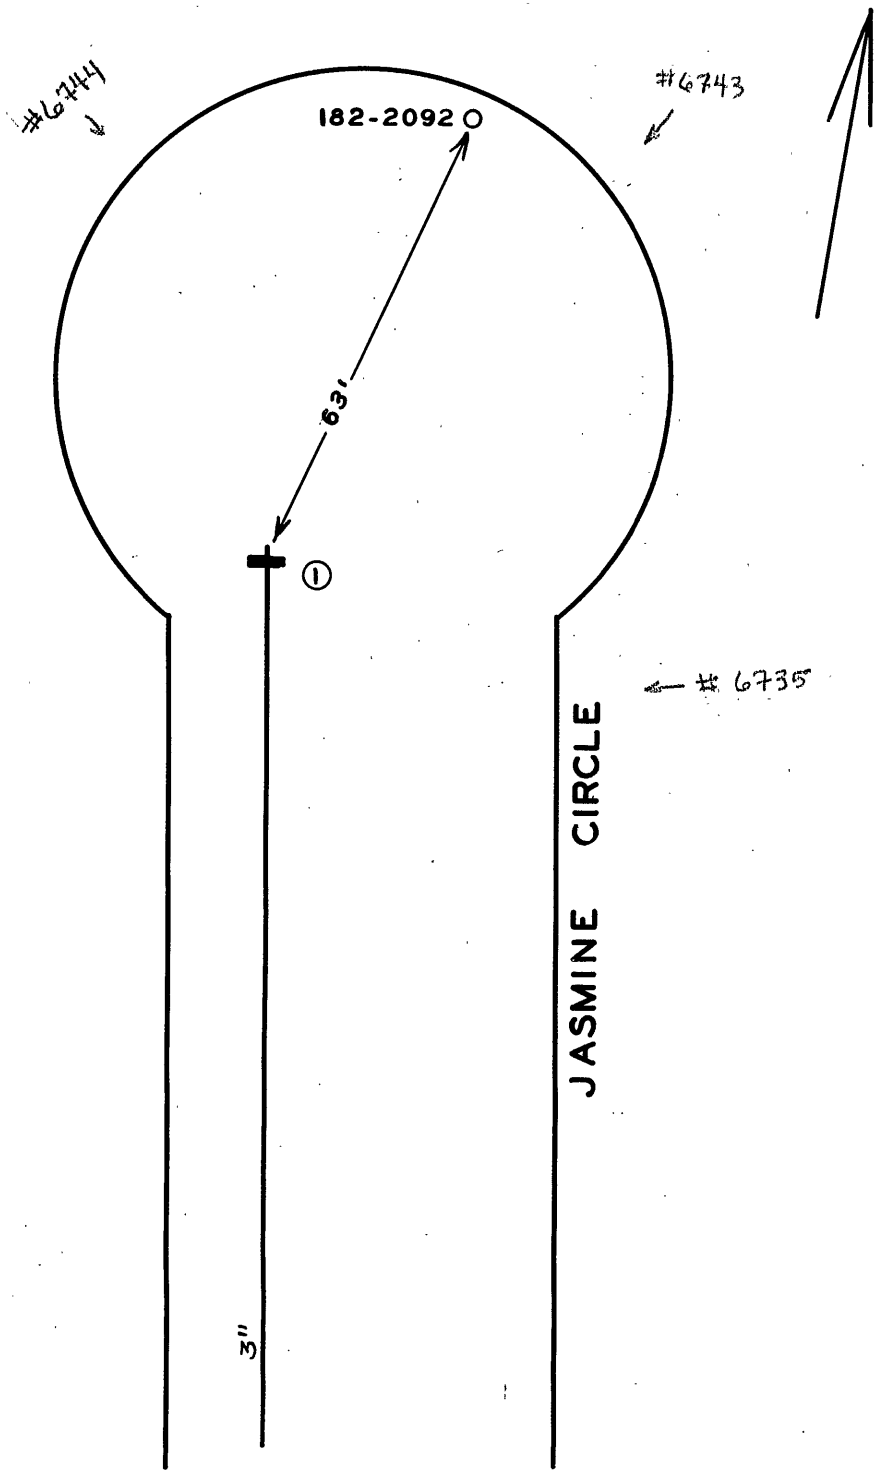

DATE	NO.	SIZE	MAKE	OPEN	TURNS
12-63	1	2	MISC.	L	

CITY OF ROANOKE—WATER DEPT.

VALVE DIAGRAM

JASMINE CIRCLE N.E.

SEC. MAP 46 Roanoke County

DATE PAGE NO.