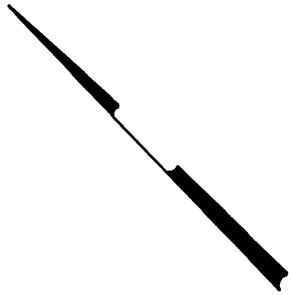

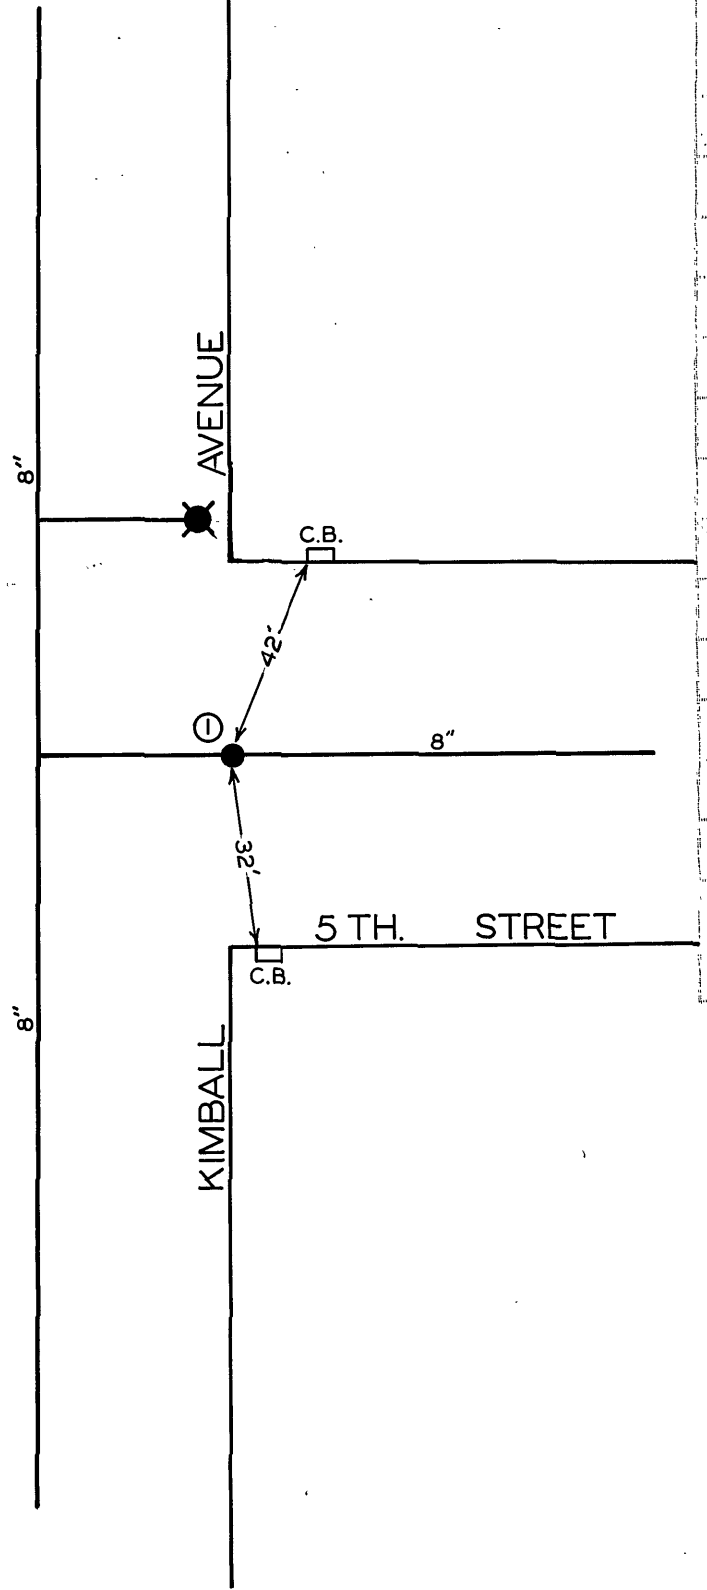

74	1	8"	MUELLER	R	

KIMBALL AVENUE &
5 TH. STREET

301 N.E.

11/2000 JH