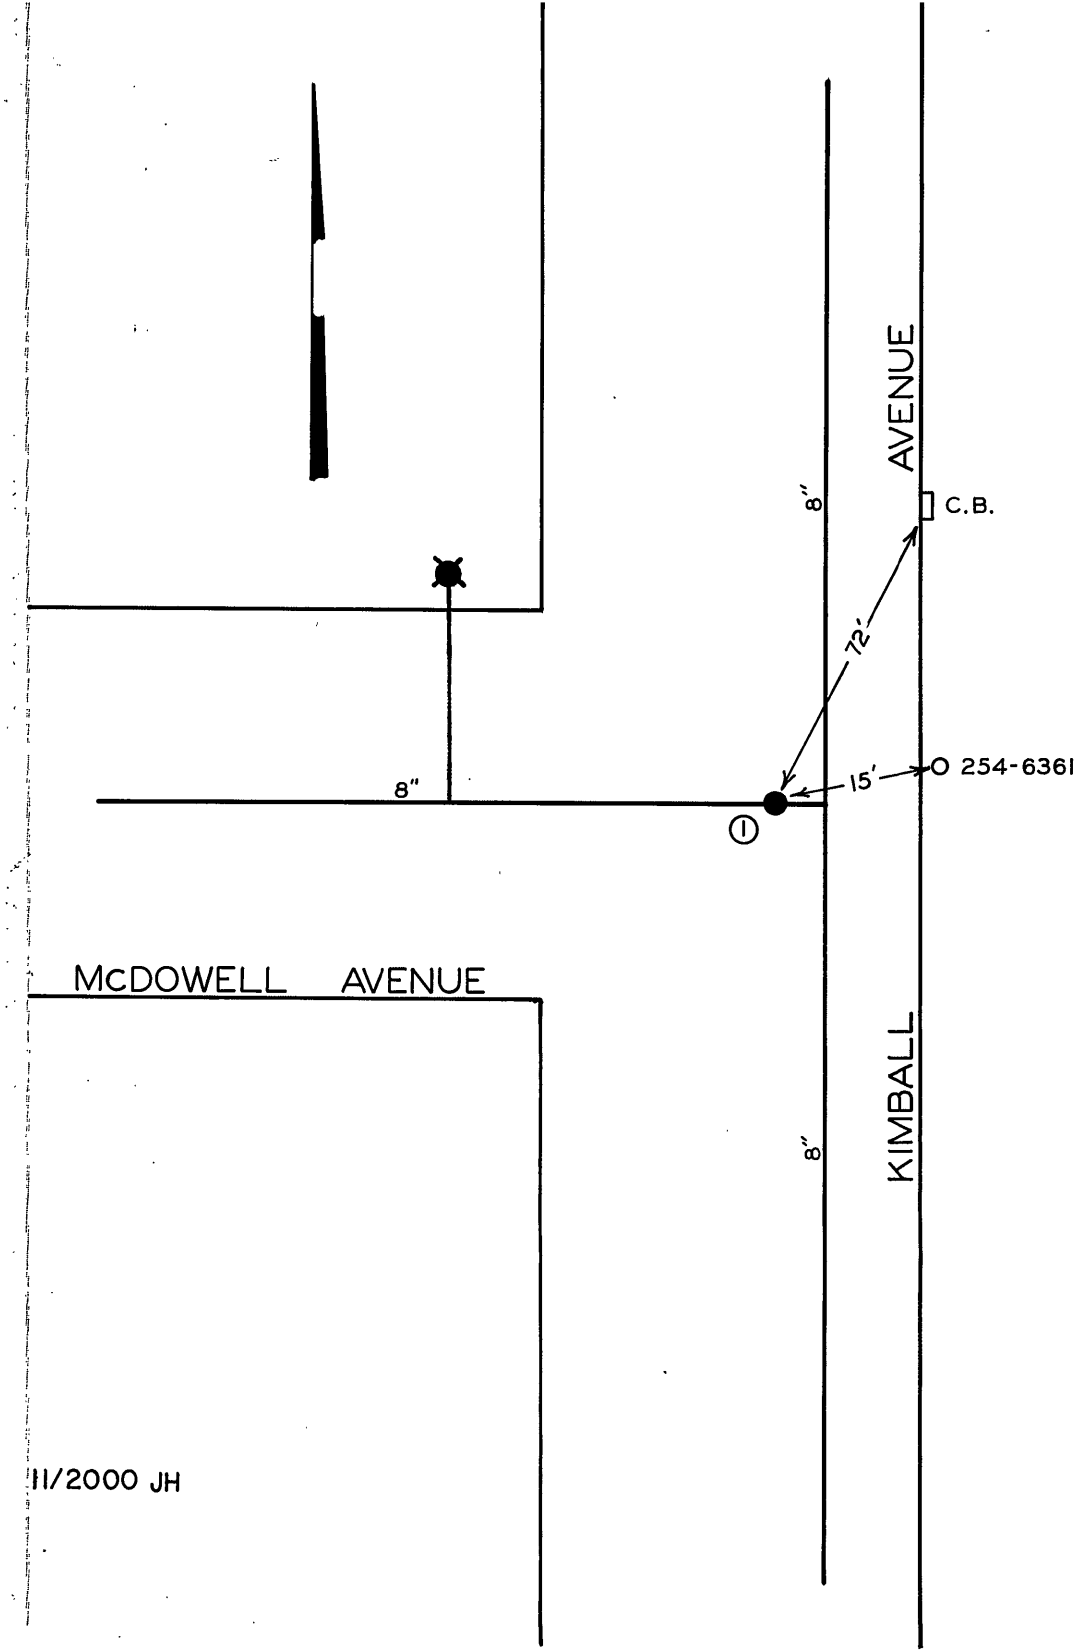

DATE	NO.	SIZE	MAKE	TURNS	DATE
74	1	8"	MUELLER	R	

CITY OF ROANOKE—WATER DEPT

VALVE DIAGRAM

KIMBALL AVENUE &

McDOWELL AVENUE

SEC. NO. 302, 303 N.E.

DATE PAGE NO.