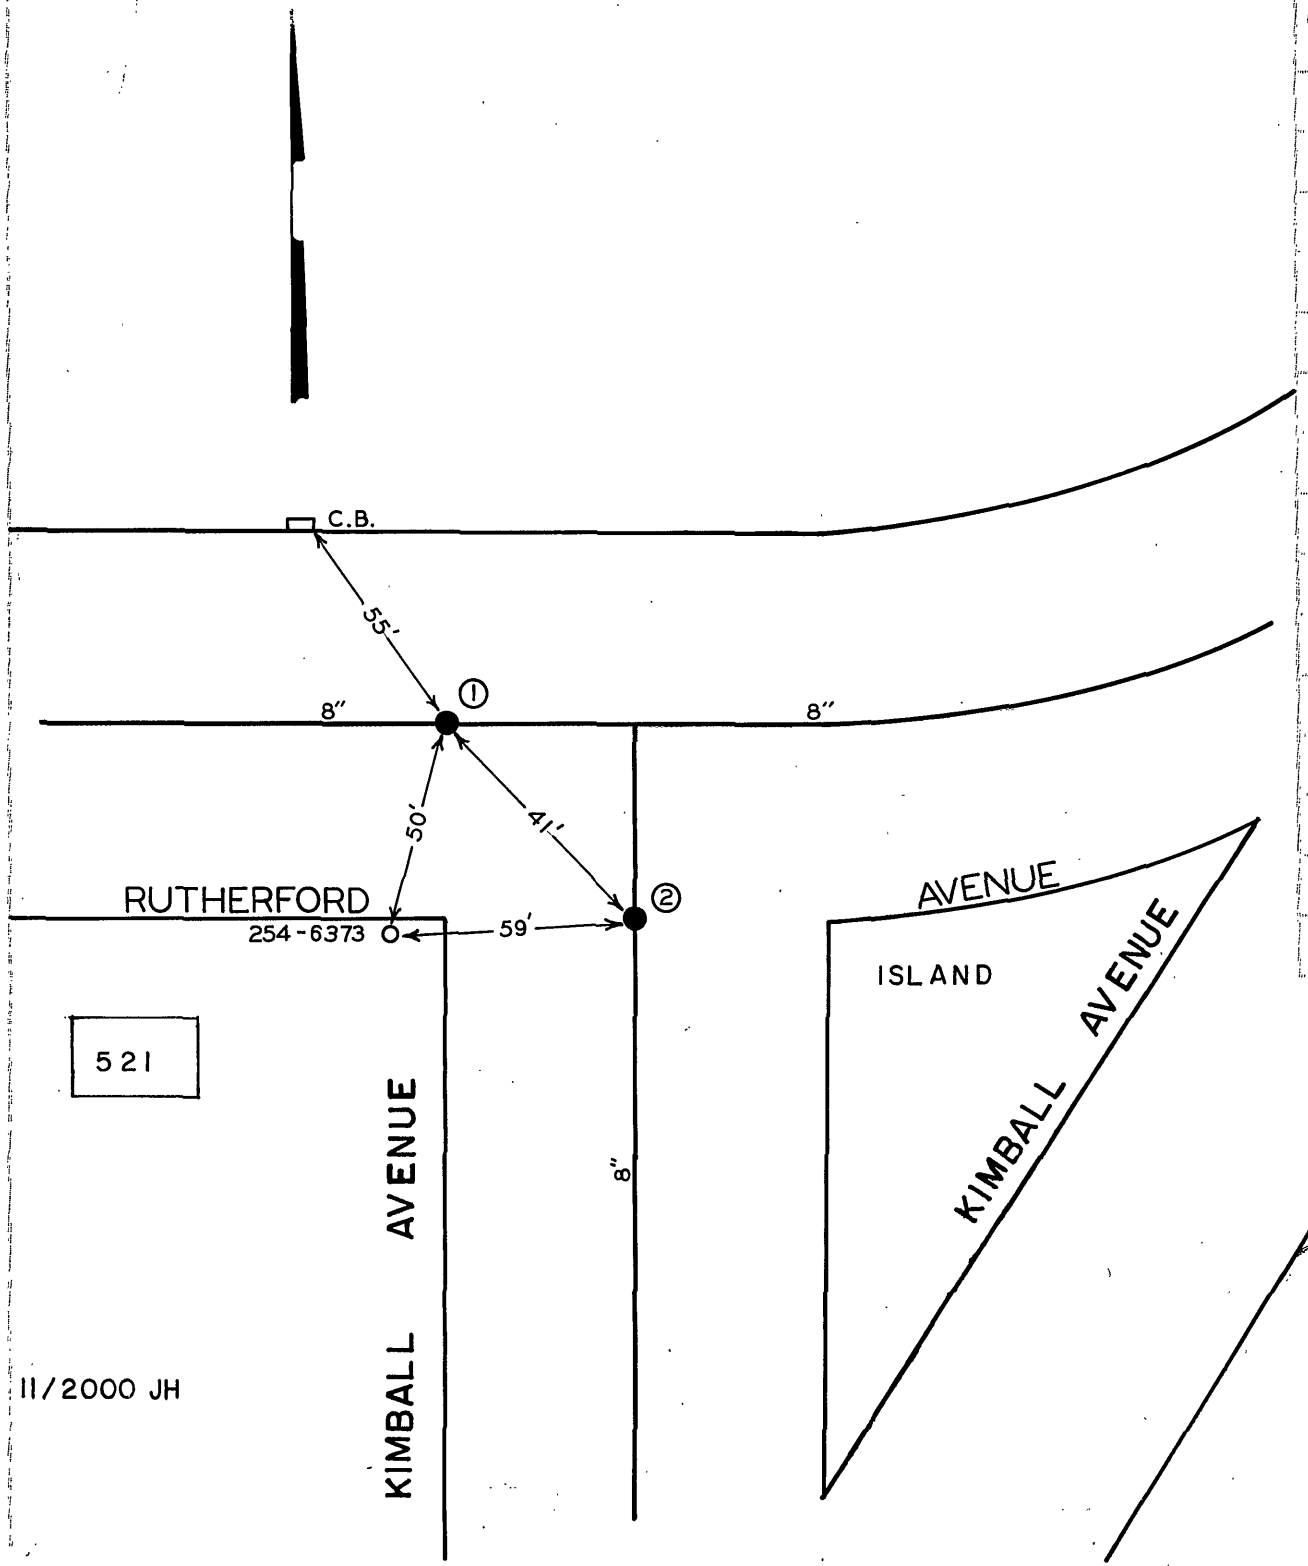

DATE	NO.	SIZE	LAKE	LOCN	TOOLS
74	1	8"	MUELLER	R	
74	2	8"	MUELLER	R	

KIMBALL AVENUE
RUTHERFORD AVE.
NE
301, 302, 303