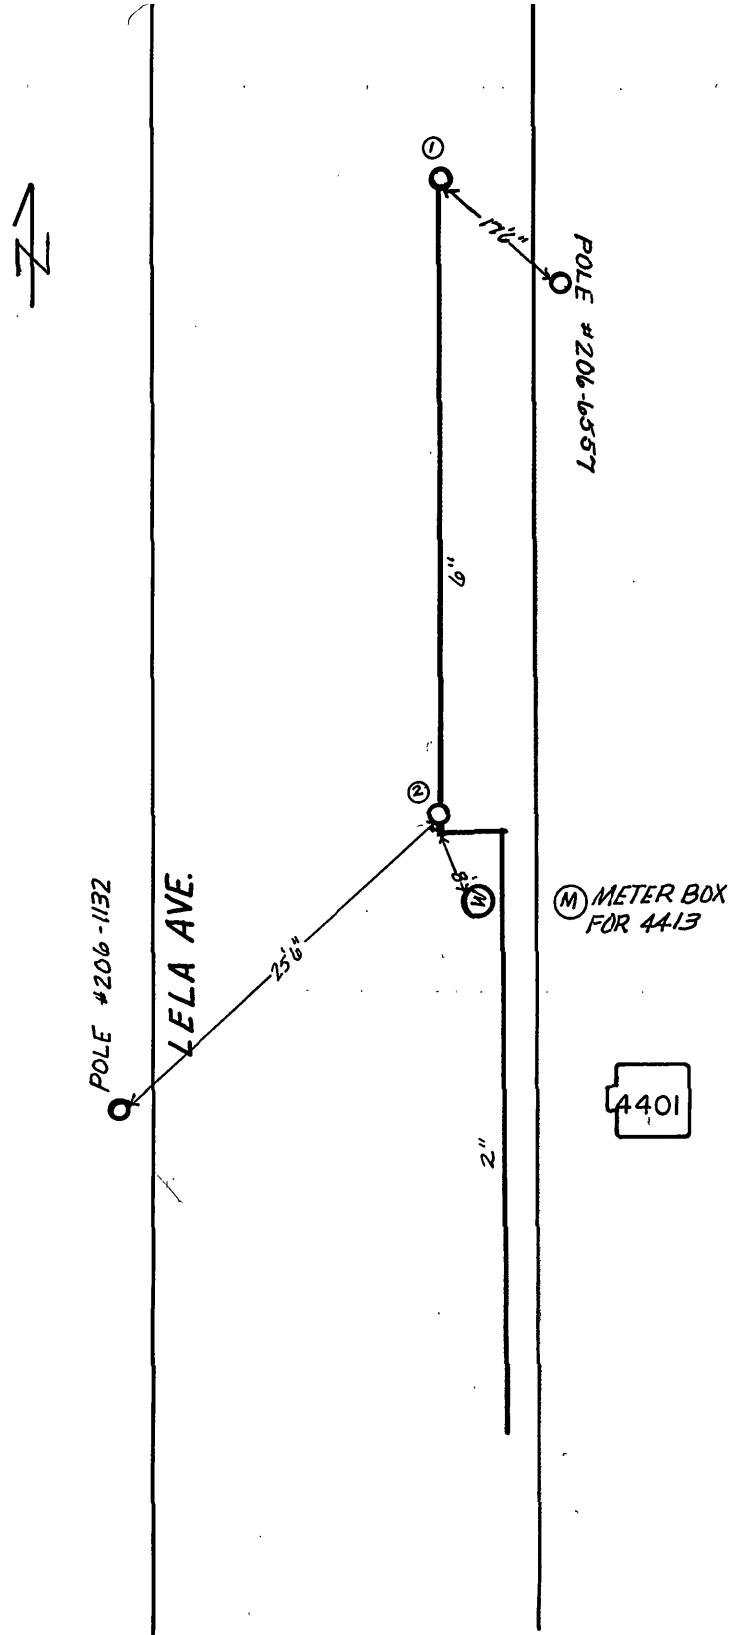

DATE	NO.	SIZE	TYPE	OPEN	TURNS
1978	1	2"	MISC.	BLOW	OFF
1978	2	2"	MISC.	L	

CITY OF ROANOKE - WATER DEPT

VALVE DIAGRAM

4405 LELA AVE.

GRID MAP 319, 735 N.E.

DATE PAGE NO.

11/2000 JH