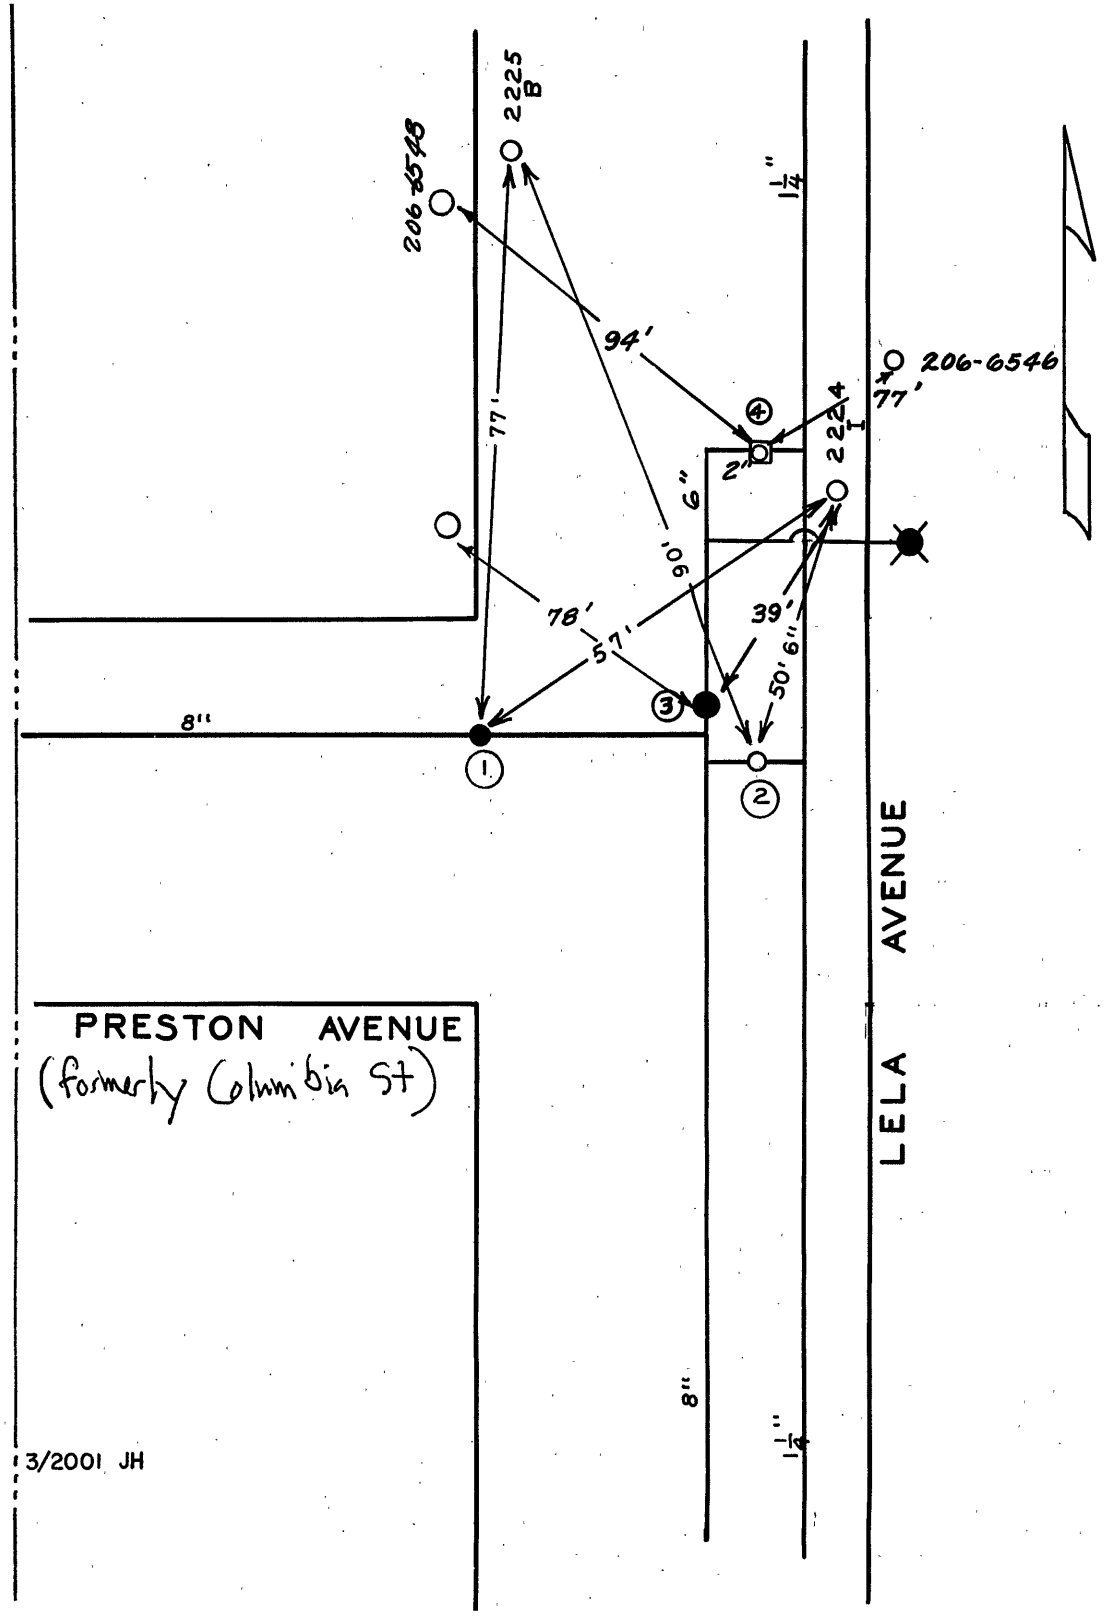

DATE	NO	SIZE	MAKE	OPEN	TURNS
1-67	1	8"	MUELLER	R	
1-67	2	2"	MISC.	L	
7-77	3	6"	DARLING	R	
7-77	4	2"	DARLING	R	
	1	0	W.P.L.		

CITY OF ROANOKE—WATER DEPT.

VALVE DIAGRAM

LELA AVENUE & [illegible]

PRESTON AVENUE

SEC. MAP 319, 330 N.E.

DATE PAGE NO.