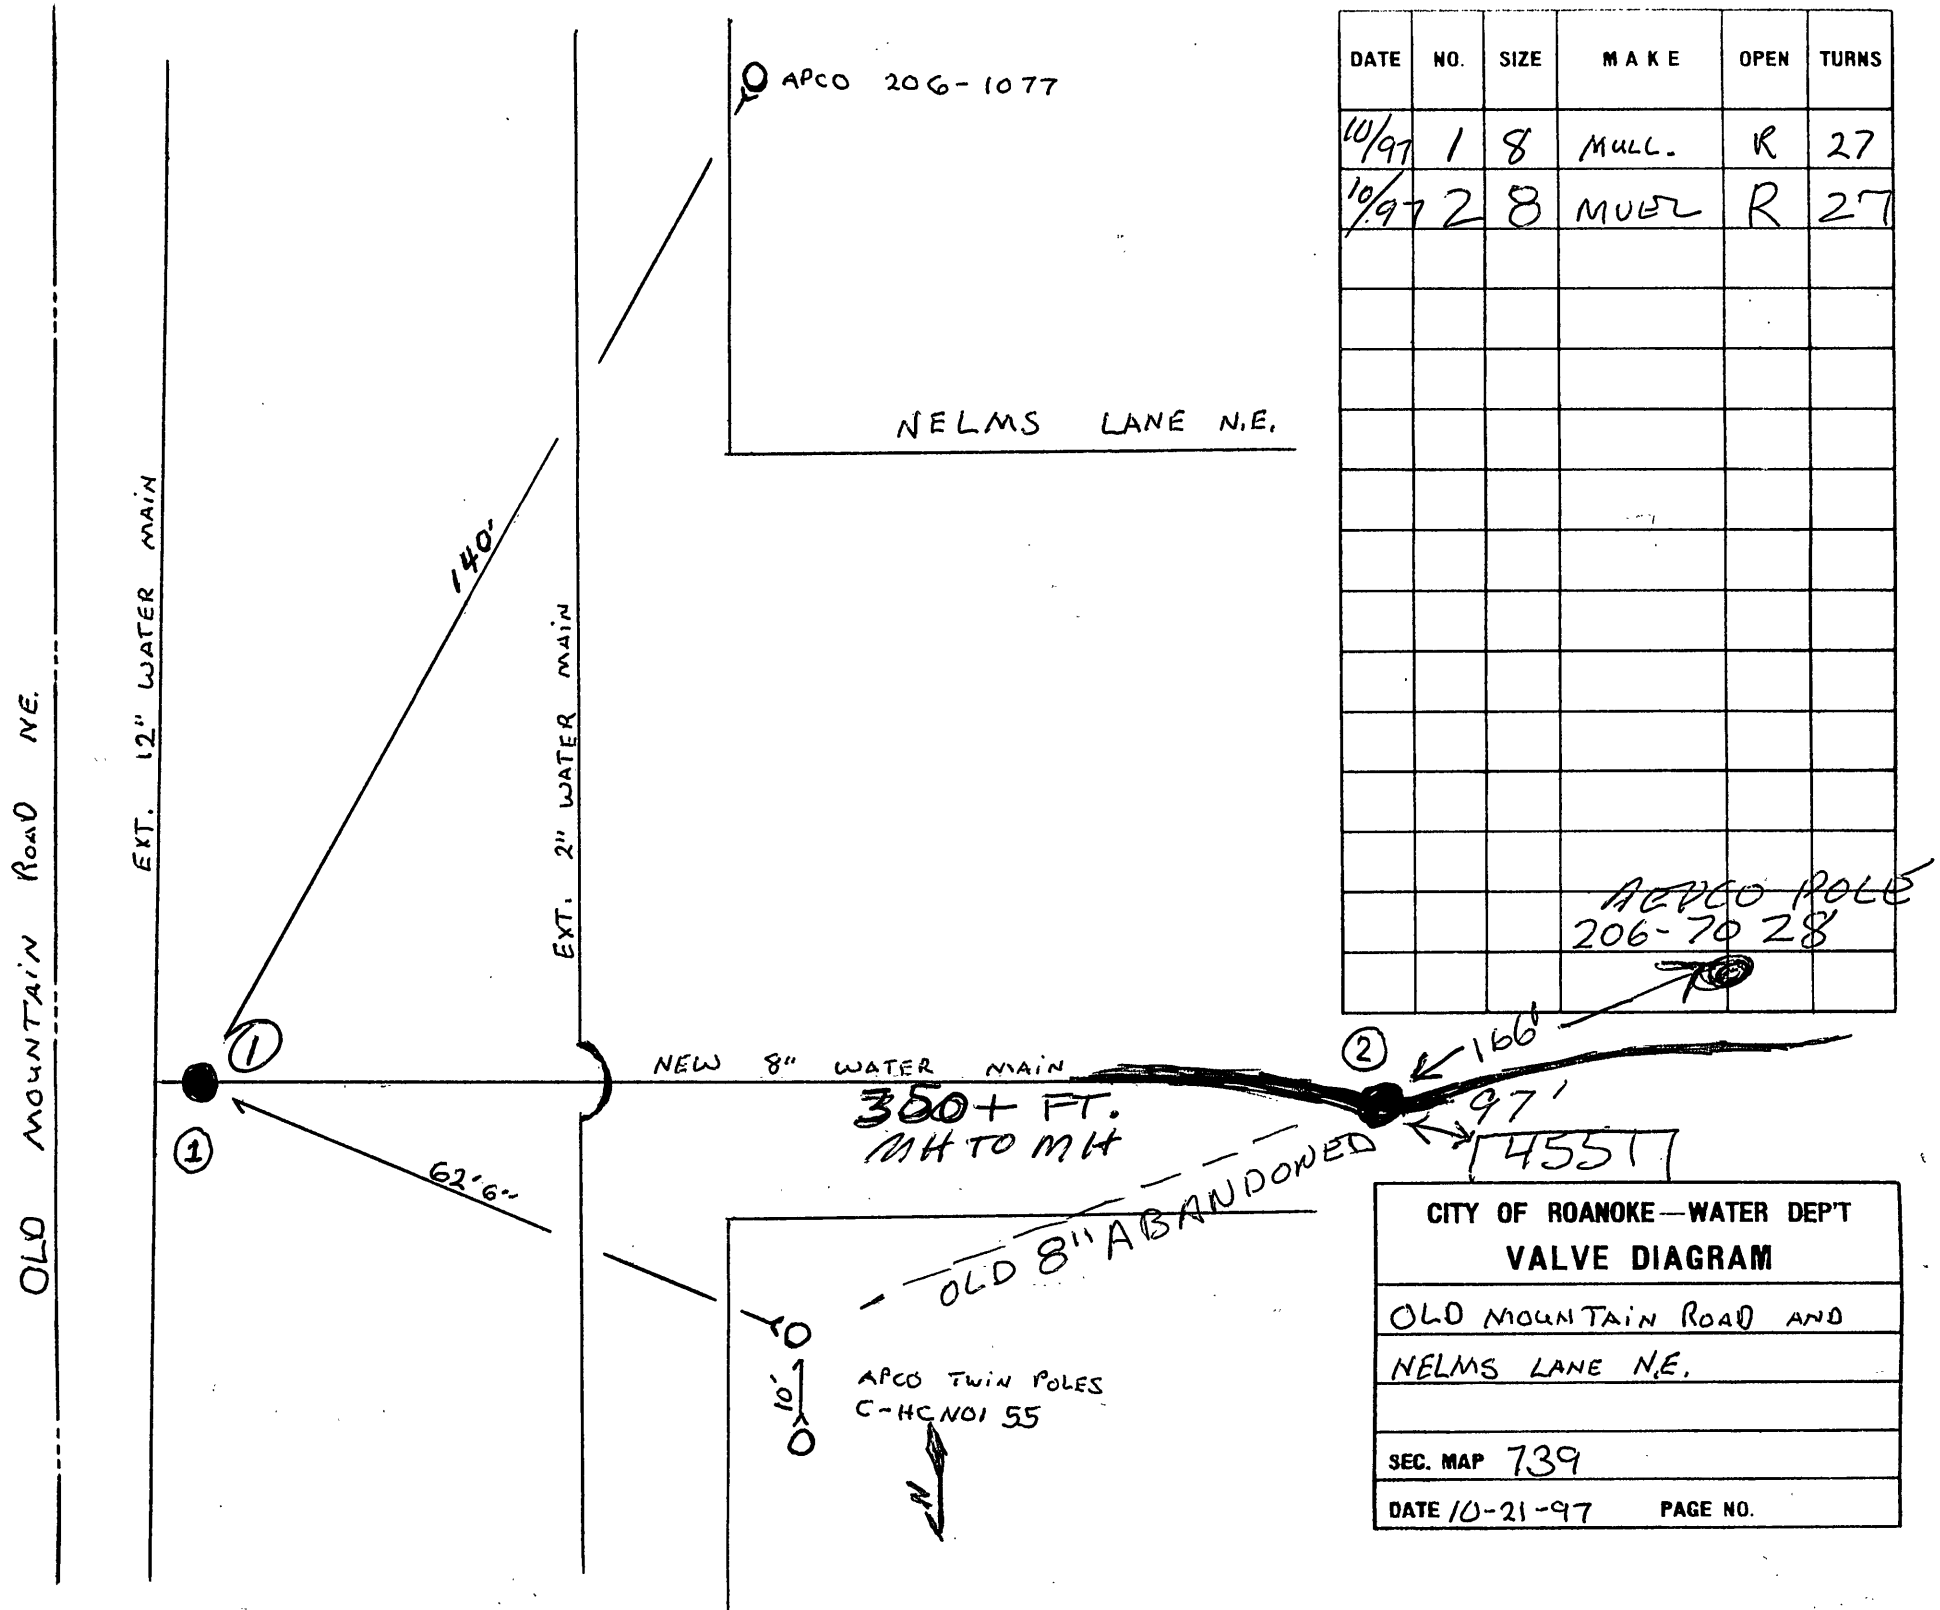

DATE	NO.	SIZE	MAKE	OPEN	TURNS
10/97	1	8	MULL.	R	27
10/97	2	8	MUEL	R	27