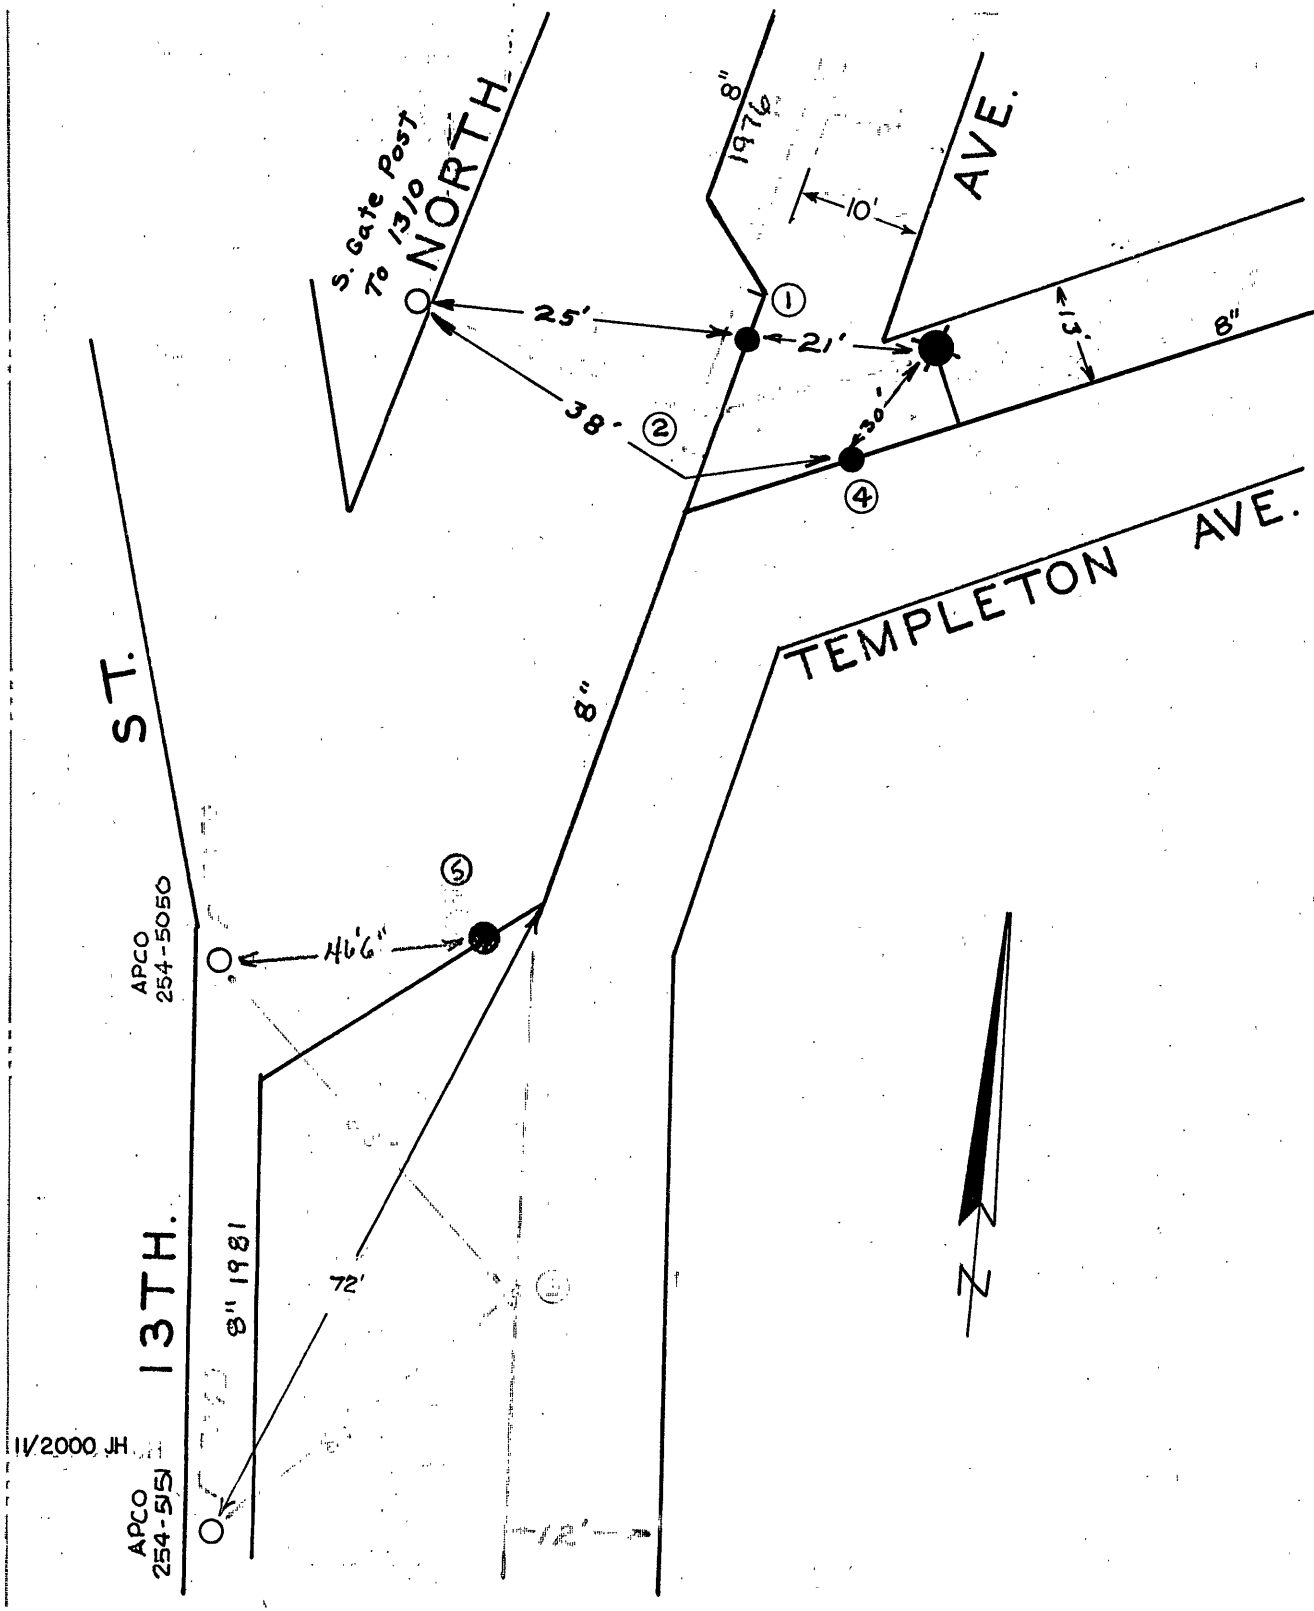

DATE	NO.	SIZE	MAKE	OPEN	TURNS
1952	1	8"	MUELLER	R	
1952	4	8"		R	
1981	5	8"	Mueller	R	
	1	9'-N	N PL		
	2	0	N PL		
	3	154'-S	S PL		
	4	0	E PL		

CITY OF ROANOKE—WATER DEPT.

VALVE DIAGRAM

NORTH AVE. & [illegible]

TEMPLETON AVE. & [illegible]

13 th. ST.

SEC. MAP 323 N. E.

DATE PAGE NO.

11/2000 JH

"IMPERIAL" TRACING CLOTH K & E CO., N. Y.