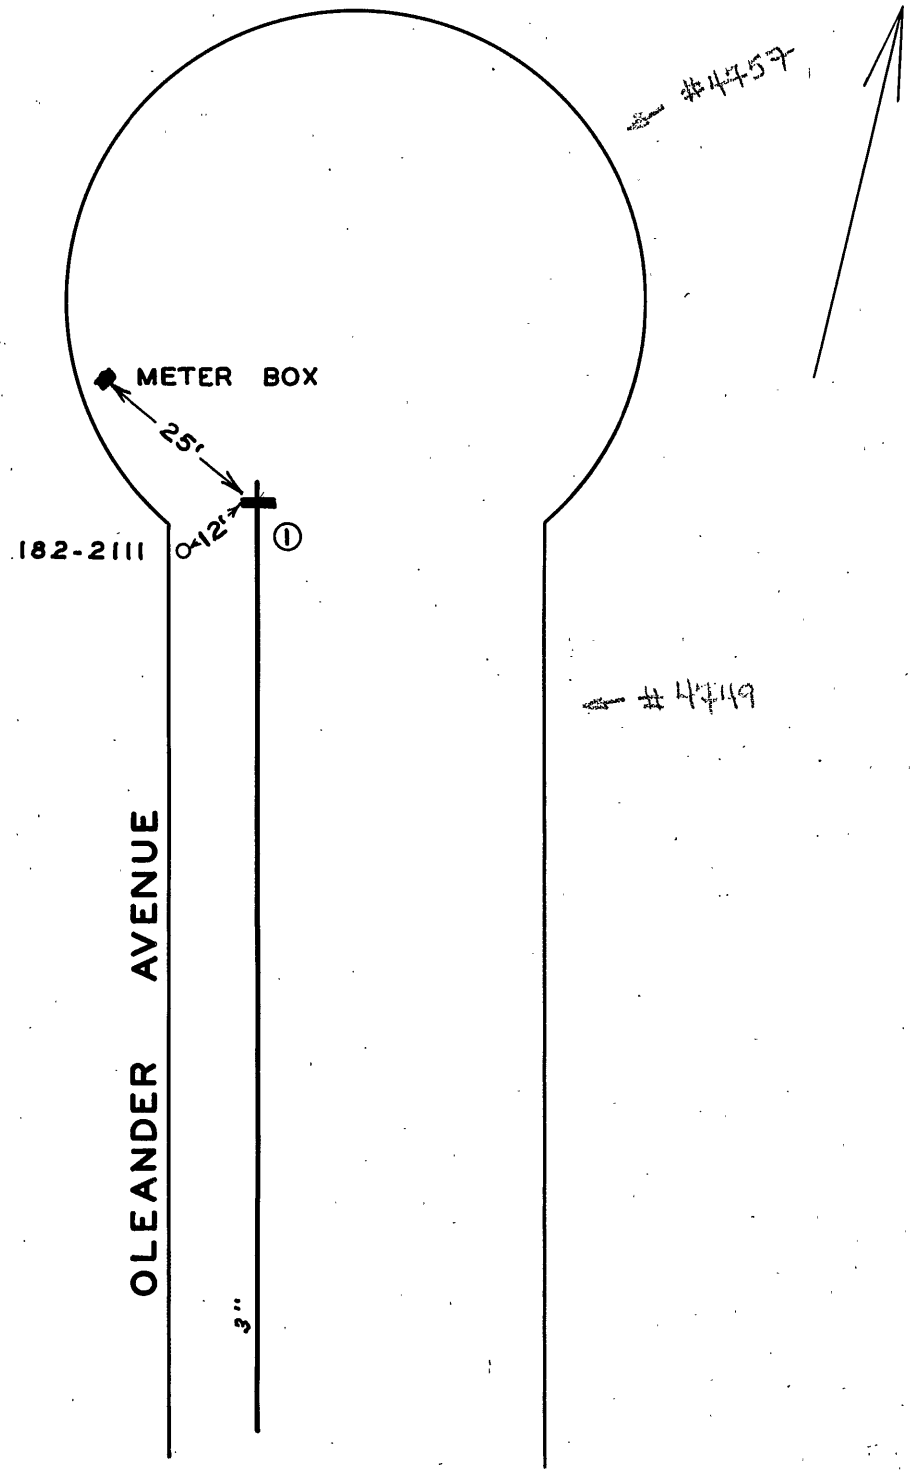

DATE	NO.	SIZE	MAKE	OPEN	TURNS
12-63	1	2"	MISC.		

CITY OF ROANOKE—WATER DEPT.

VALVE DIAGRAM

OLEANDER AVENUE N.E.

SEC. MAP 46 Roanoke County

DATE PAGE NO.