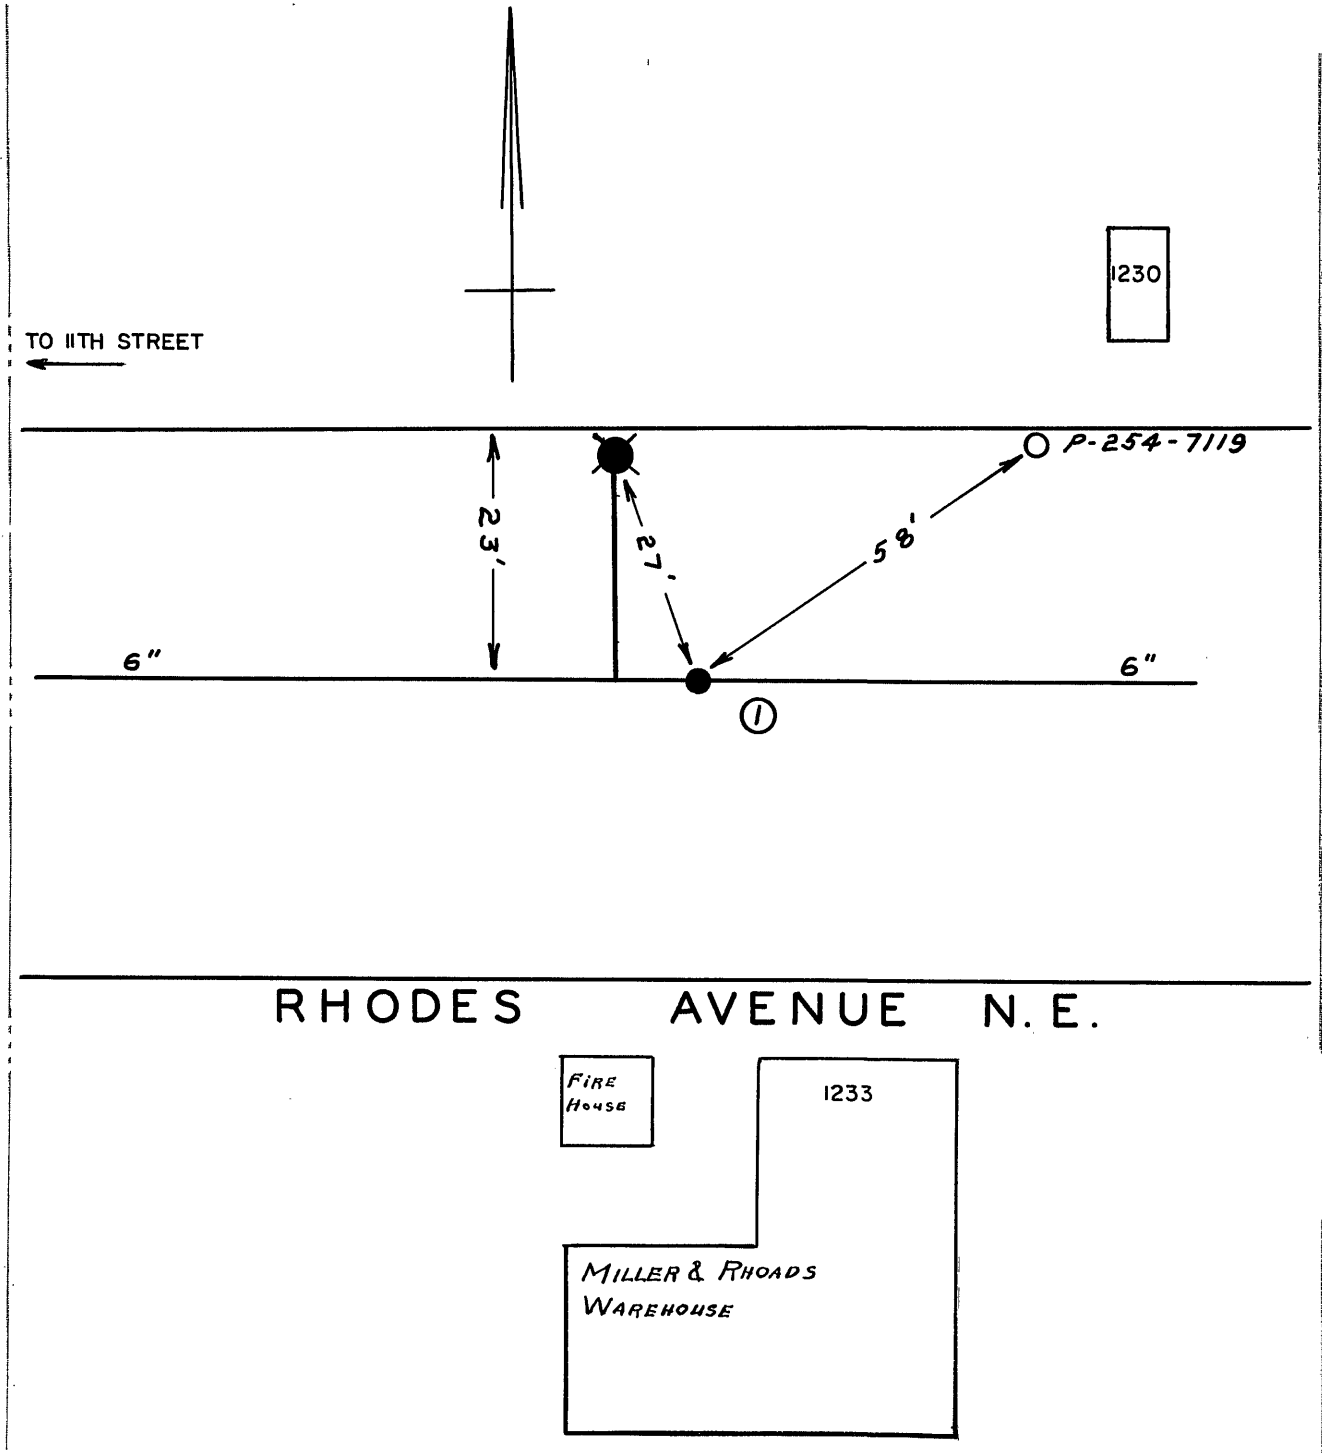

DATE	NO.	SIZE	MAKE	OPEN	TURNS
57	1	6"	DARLING	R	

CITY OF ROANOKE – WATER DEPT.

VALVE DIAGRAM

RHODES AVE. AT

MILLER & RHOADS WAREHOUSE

1200 BLOCK

SEC. MAP 305 NE

DATE PAGE NO.

3/91 NP