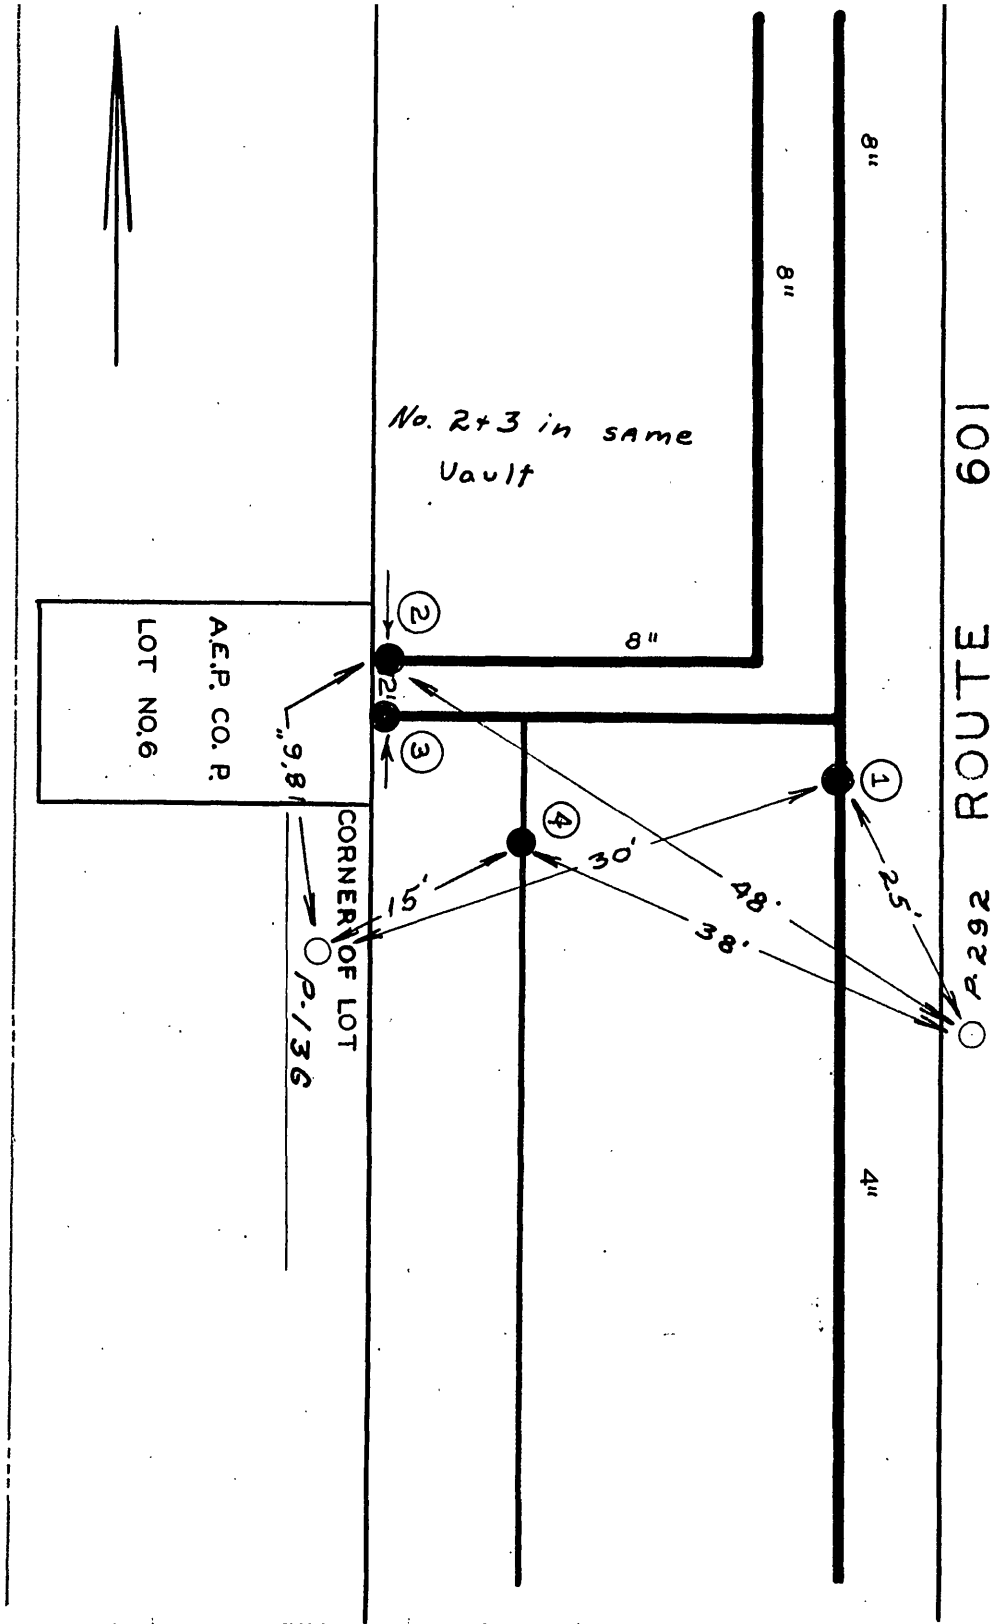

DATE	NO.	SIZE	MAKE	OPEN	TURNS
1947	1	4"	DARLING	R	9
1947	2	8"	DARLING	R	27
1947	3	8"	DARLING	R	27
	4	8"	MUELLER	R	26½

Abandoned
(updated Sep 6/2005)

CITY OF ROANOKE—WATER DEP'T
VALVE DIAGRAM
VA. ROUTE 601
PUMPING STATION
(Shadwell Dr. + Old Hollins Rd.) Rte. 601 is
SEC. MAP
DATE 11/10/47, PAGE NO. NE 104