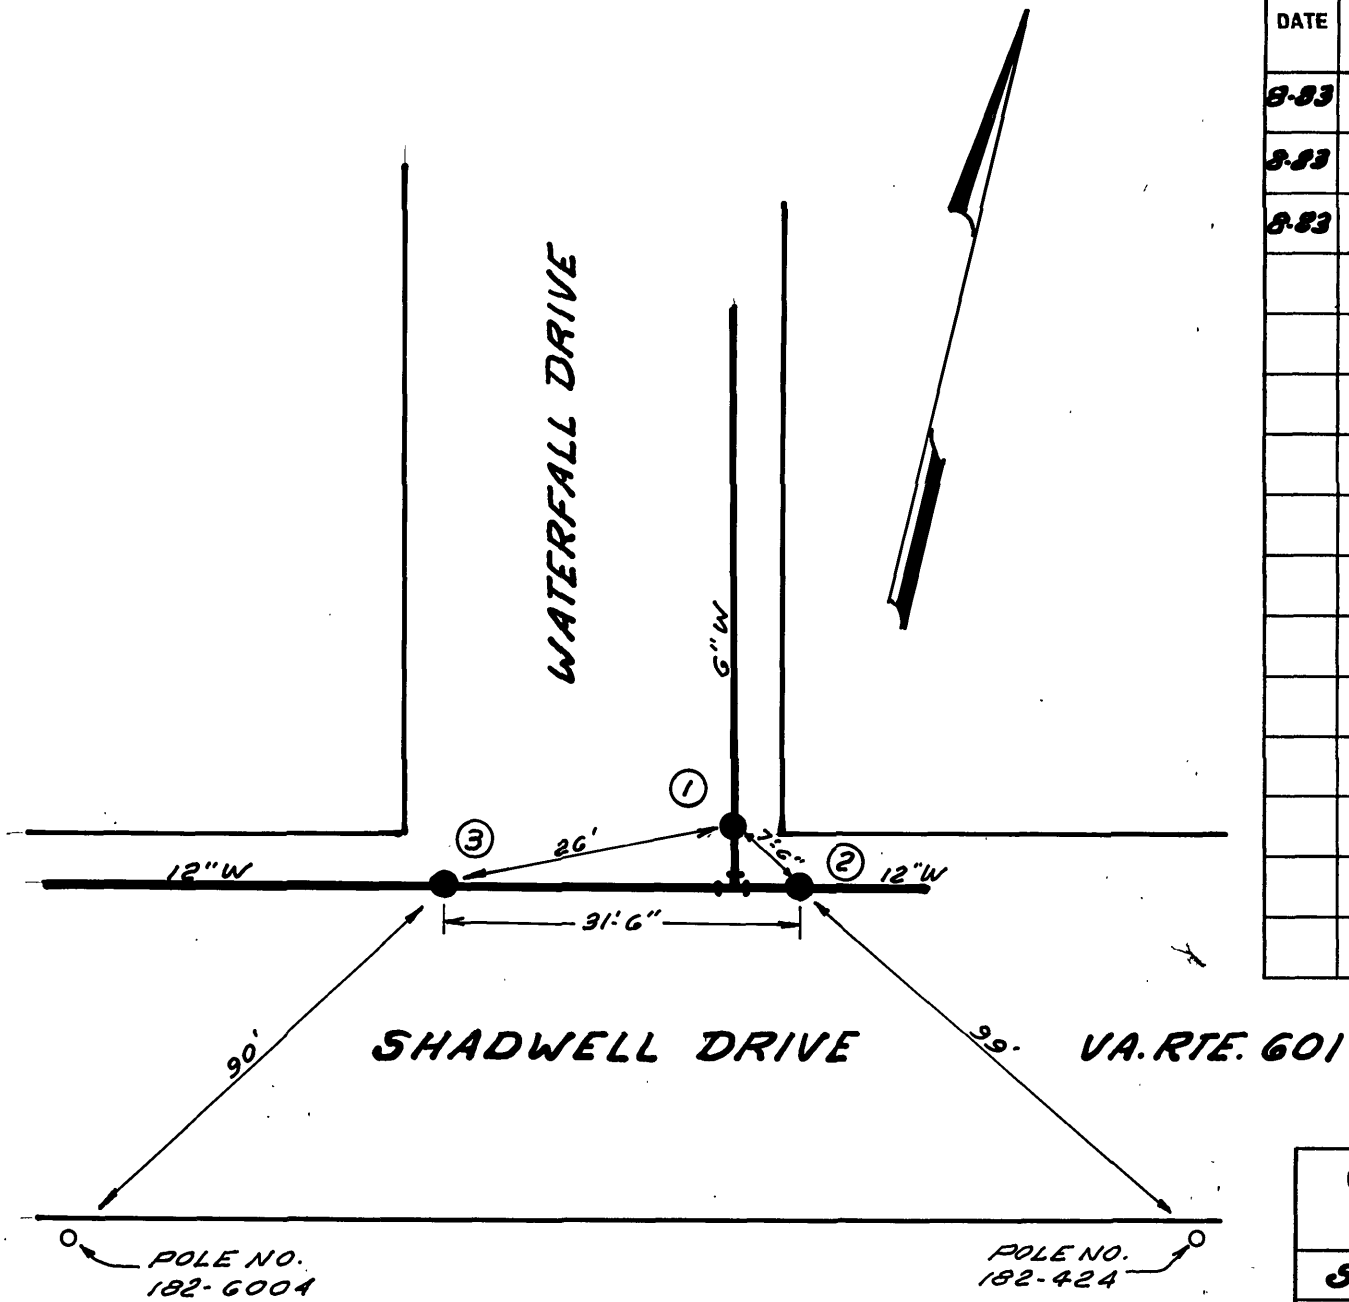

DATE	NO.	SIZE	MAKE	OPEN	TURNS
8-83	1	6"	MULLER	R	21
8-83	2	12"	KENNEDY	R	39
8-83	3	12"	KENNEDY	R	39

CITY OF ROANOKE—WATER DEP'T

VALVE DIAGRAM

SHADWELL DRIVE AND

WATERFALL DRIVE, N.E.

SEC. MAP

DATE PAGE NO.