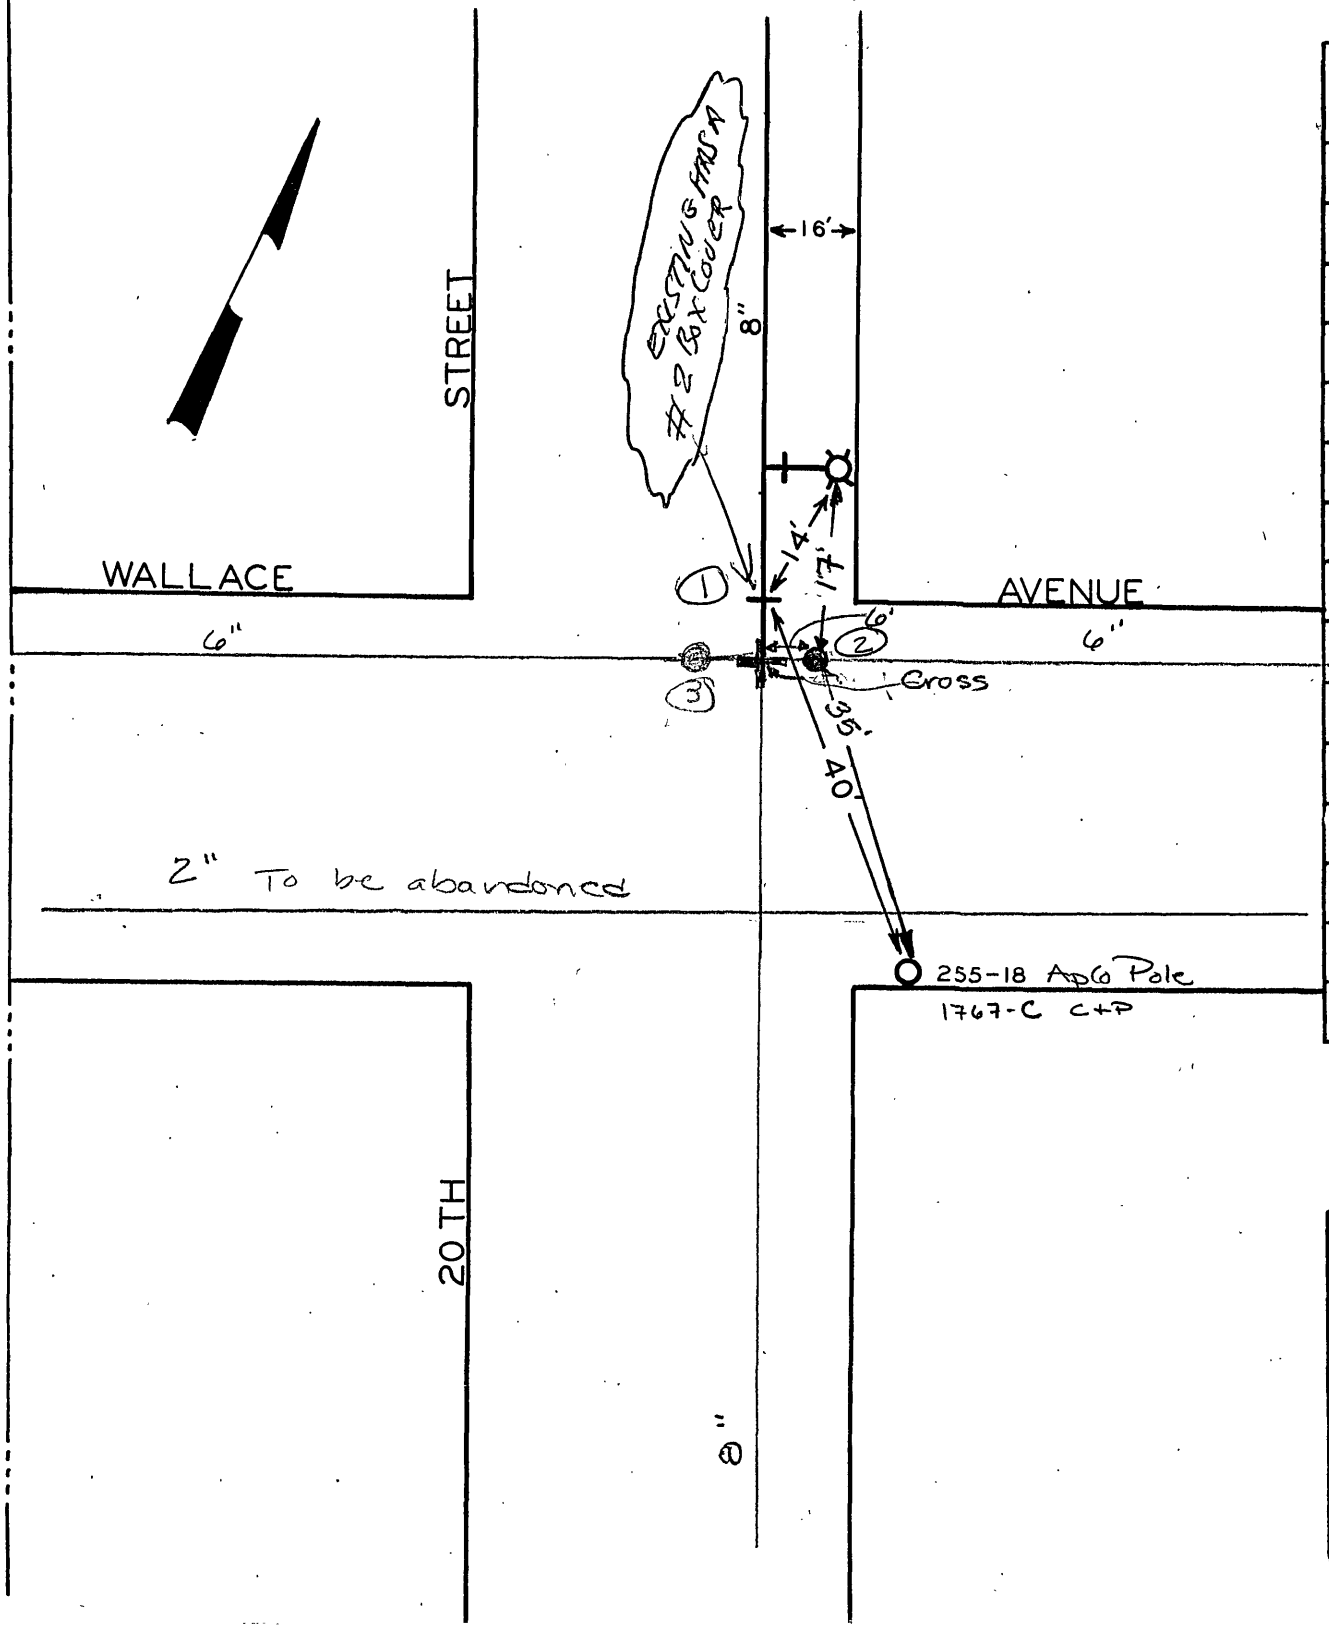

DATE	NO.	SIZE	MAKE	OPEN	TURNS
9-68	1	8"	MUELLER	R	
1990	2	6"	Mueller	R	
1990	3	6"			
	1	0	W.P.L.		

CITY OF ROANOKE—WATER DEPT.

VALVE DIAGRAM

WALLACE AVE. & 20TH. ST. N.E.

SEC. MAP 333

DATE **PAGE NO.**