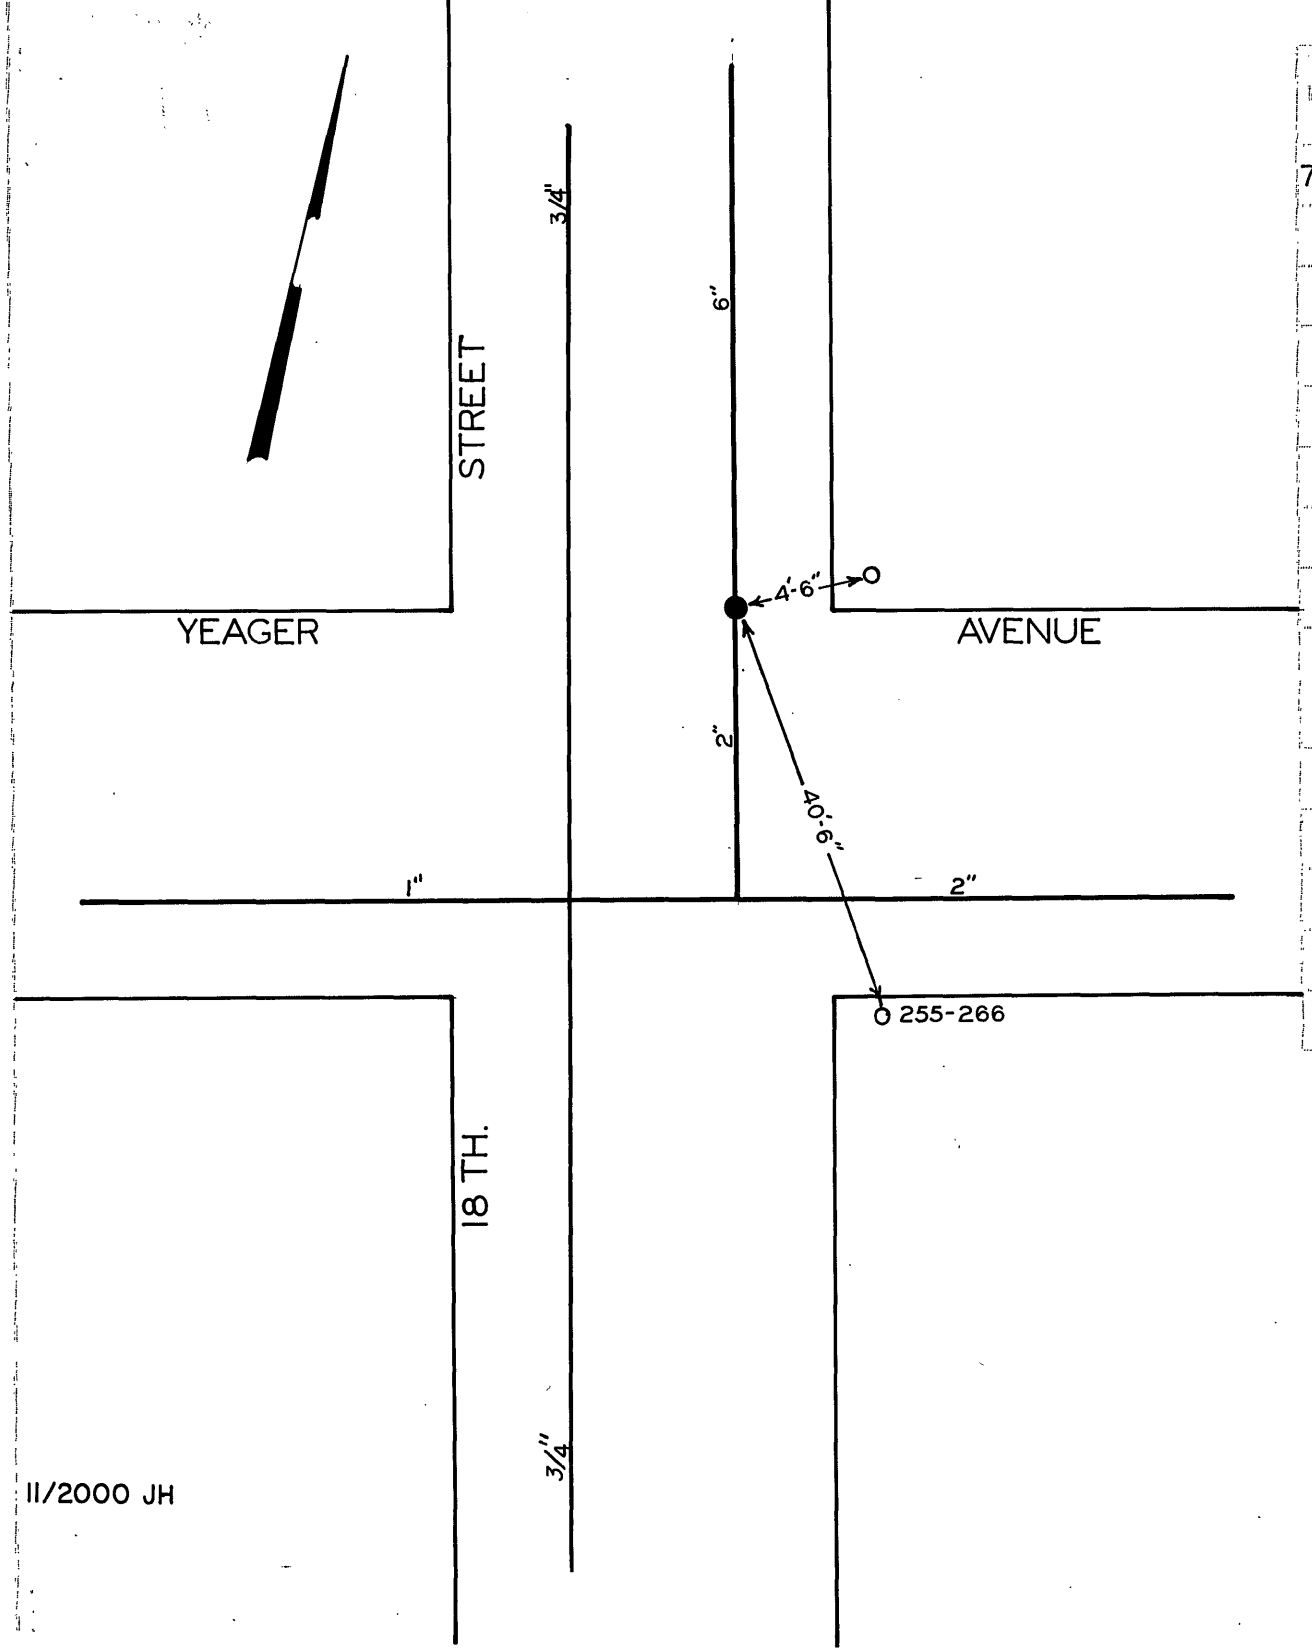

DATE	NO.	SIZE	CLASS	OPEN	TURNS
7-72	1	6"	MUELLER	R	

CITY OF [illegible]
[illegible]

YEAGER AVENUE &
18 TH. STREET

SEC. AND 323 N. E.

DATE PAGE [illegible]