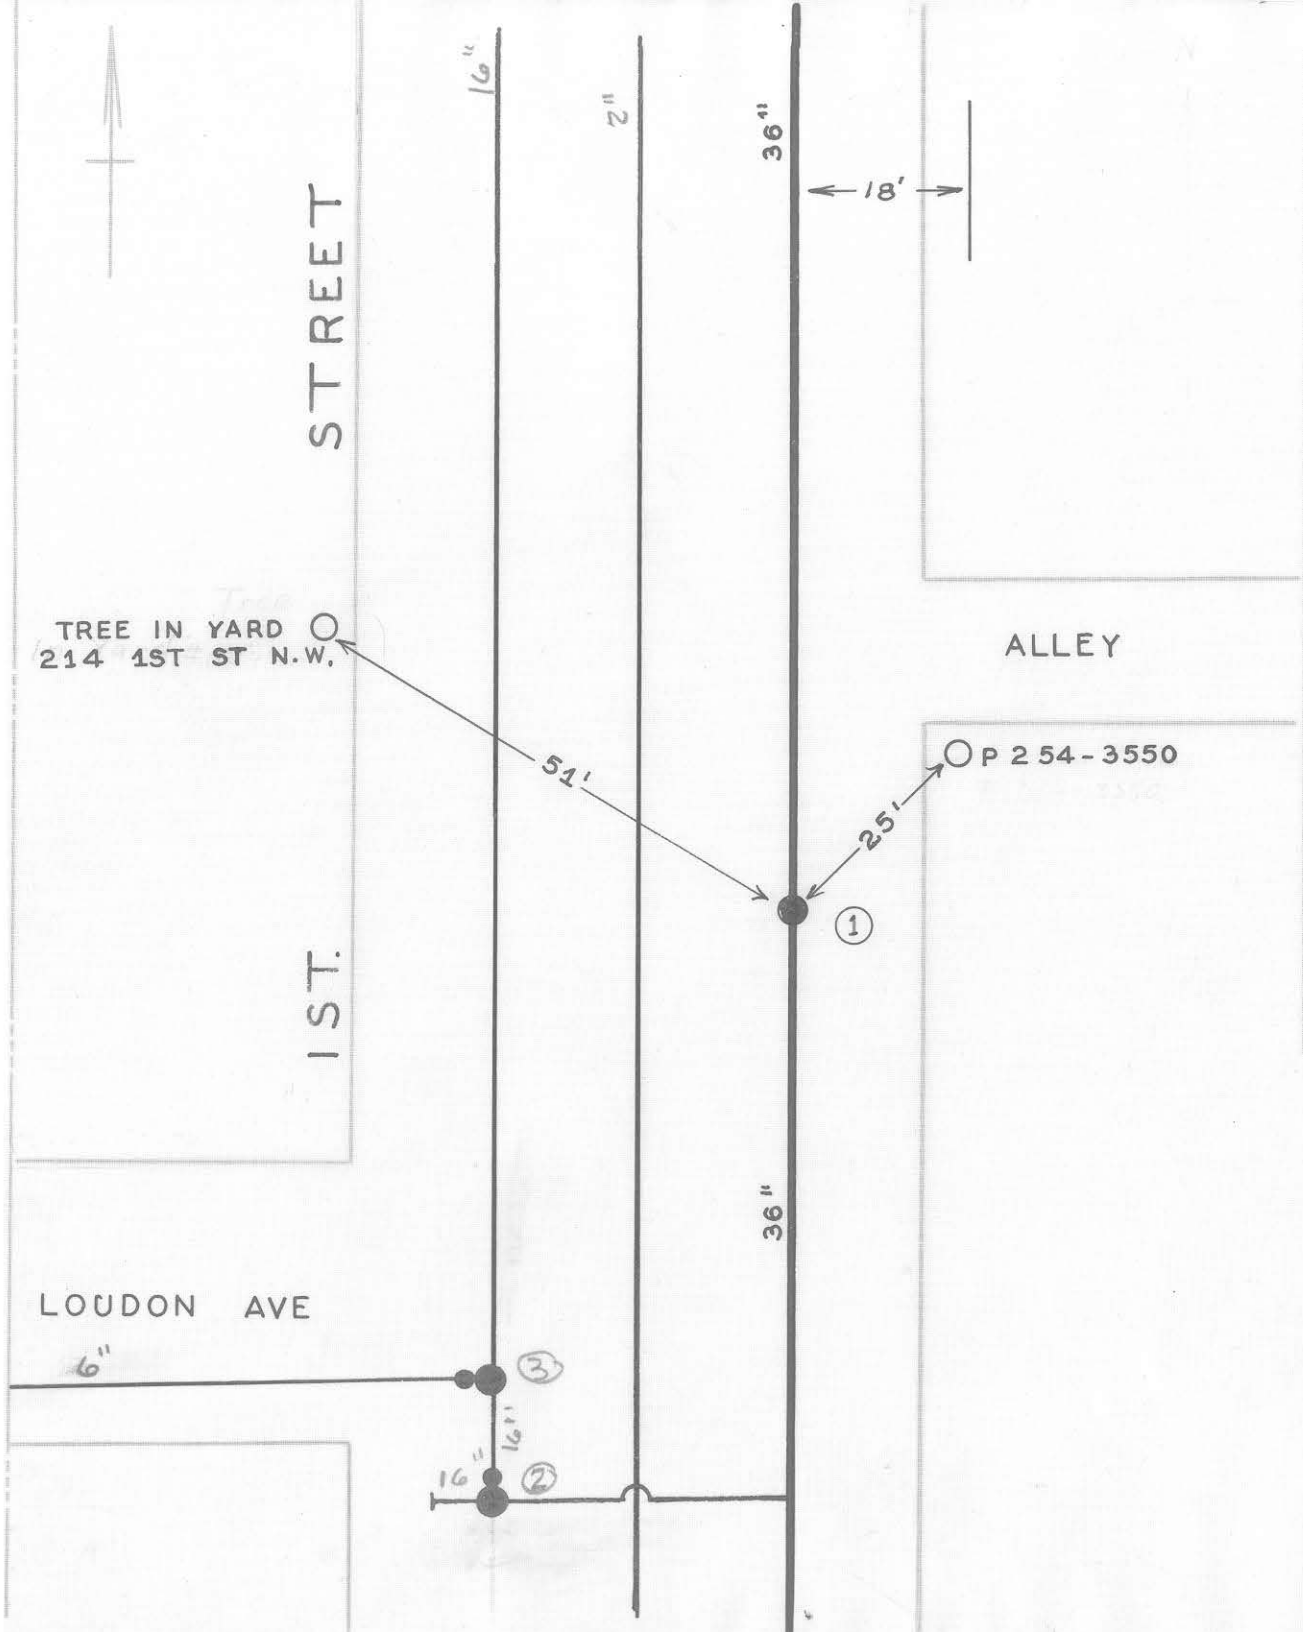

DATE	NO.	SIZE	MAKE	OPEN	TURNS
1946	1	1	SIMPLEX	AIR	VALVE
1995	2	16"	Bypass		
1995	3	16"	Bypass		
	1	109'-N	NPL		

CITY OF ROANOKE—WATER DEP'T

VALVE DIAGRAM

1ST. ST. 109' N. OF.

LOUDON AVENUE N.W.

SEC. MAP 201

DATE

PAGE NO. N.W.312